91730 3.00

IREDELL COUNTY HEALTH DEPARTMENT

STATESVILLE 704-878-5305 MOORESVILLE 704-664-5281

IMPROVEMENT PERMIT / AUTHORIZATION TO CONSTRUCT / OPERATION PERMIT / EXISTING SYSTEM INSPECTION

PERMIT# Trotman 08-2-699 PIN# 4730486413 DATE 8/18/99

OWNER OR CONTRACTOR C & S Assoc. PHONE: Business 336-475-4111 Home

ADDRESS 904 Salem St. Thomasville NC 27360

LOCATION DEPTH RDS - TR State Park - TR Meadow Glen - TL Whitney Ln - on RT at End

SUBDIVISION Meadow Glen BLOCK / SECTION LOT 46 LOT AREA .3444 AC SITE CLASS PS DESIGN FLOW 360 L.T.A.R. .3 gal/sq ft

Septic Tank: 1000 Gallons; STB 825 Date 8/16/00
Pump Tank: Gallons; PT Date
Pump Make: Model Serial No.
Nitrification Field: No Fields 1 Square Feet 900 Linear Feet 300
No Lines 3 @ 100' Trench Width 36" Max Trench Bottom Depth 36" Gravel Depth N/A

☑ New System ☐ Repair System Type: I, II, III, IV, V, VI
System Description: GRAVITY 25% REDUCTION
Repair System Description: PUMP PANEL
Maintenance Agreement Required: ☐ Yes ☑ No
☐ Slab ☑ Crawl Space ☐ Basement w/plumbing ☐ Basement wo/plumbing


☑ House/Mod. Home No. Bedrooms 3
☐ Mobile Home No. Bathrooms 2
☐ Business No. Employees
☐ Other

Water Supply: ☐ Individual ☑ Public ☐ Community

Comments/Conditions:

Comments/Conditions:

INITIAL SITE SKETCH 1"=50'

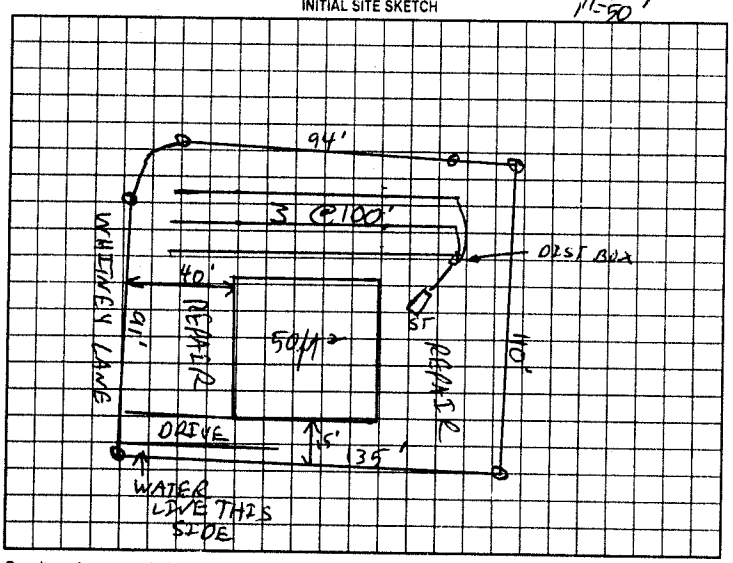

AS BUILT SKETCH

Permit can be suspended or revoked if any false information is supplied toward securing the permit/any unauthorized changes are made to the site/any unauthorized changes are made in the installation of the system. Improvement Permit with plat valid without expiration. Improvement Permit with site plan valid for sixty months. Authorization to Construct is valid for a period equal to that of Improvement Permit - not to exceed sixty months.

Signed: date 8/31/99 Installed by: Rowan Septic

Improvement Permit by: KS date 8/18/99 Operation Permit by: RSI date 10/12/00

Authorization to Construct by: KS date 8/18/99 Existing System Inspection by: date

HEALTH DEPT. COPY: WHITE OWNER COPY (FINAL): YELLOW OWNER COPY (INITIAL): PINK