82672

IREDELL COUNTY HEALTH DEPARTMENT

STATESVILLE 704-878-5305 MOORESVILLE 704-664-5281

IMPROVEMENT PERMIT / AUTHORIZATION TO CONSTRUCT / OPERATION PERMIT / EXISTING SYSTEM INSPECTION

PERMIT# 09-2-699-TROTMAN PIN# 4730 48 6413 DATE 6/24/99

OWNER OR CONTRACTOR MAX SPEAR PHONE: Business Home 361-7518

ADDRESS 607 ANDERSON AVENUE - SALISBURY NC 28144

LOCATION PERTH RD(S) - TR STATE PARK RD - TR MEADOW GLEN - TL WHITNEY LN - ON RT NEAR END

SUBDIVISION MEADOW GLEN BLOCK / SECTION II LOT 47 LOT AREA .3448AC SITE CLASS PS DESIGN FLOW 360gal L.T.A.R. ~3gpd/ft²

Septic Tank: 1000 Gallons; STB 925 Date 7-2099
Pump Tank: Gallons; PT Date
Pump Make: Model Serial No.
Nitrification Field: No Fields 1 Square Feet 960 Linear Feet 320
No Lines 7 Trench Width 36" Max Trench Bottom Depth 36" Gravel Depth N/A

☑ New System ☐ Repair System Type: I. II (III) IV. V. VI
System Description: GRAVITY 25% REDUCTION
Repair System Description: GRAVITY PANEL
Maintenance Agreement Required: ☐ Yes ☑ No
☑ Slab ☐ Crawl Space ☐ Basement w/plumbing ☐ Basement wo/plumbing


☑ House/Mod. Home No. Bedrooms 3
☐ Mobile Home No. Bathrooms 2
☐ Business No. Employees
☐ Other

Water Supply: ☐ Individual ☑ Public ☐ Community


Comments/Conditions:

Comments/Conditions

INITIAL SITE SKETCH 1"=50'

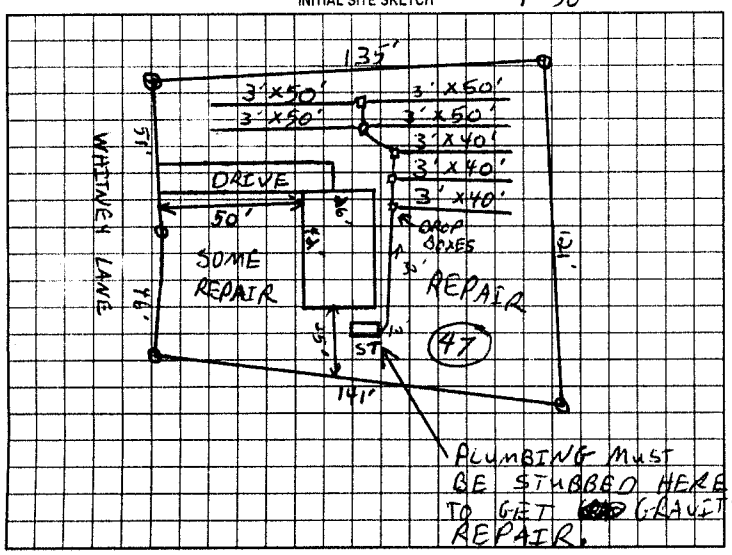

AS BUILT SKETCH

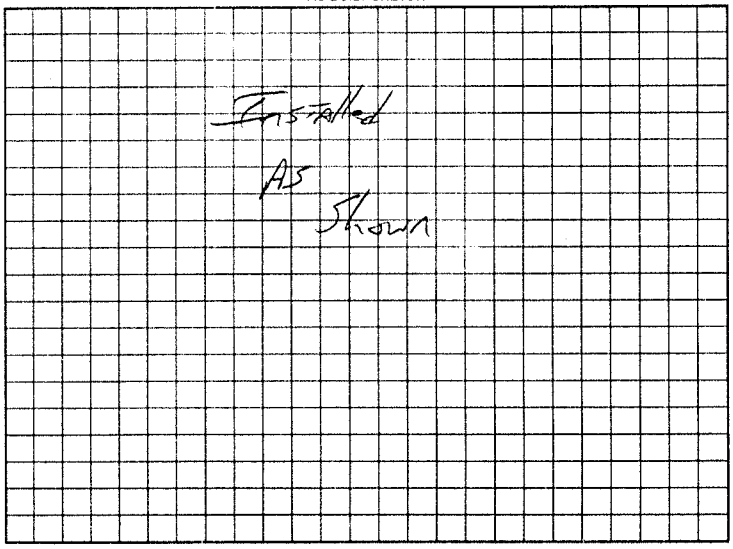

Permit can be suspended or revoked if any false information is supplied toward securing the permit/any unauthorized changes are made to the site/any unauthorized changes are made in the installation of the system. Improvement Permit with plat valid without expiration. Improvement Permit with site plan valid for sixty months. Authorization to Construct is valid for a period equal to that of Improvement Permit - not to exceed sixty months.

Signed: date 6/29/99 Installed by: Rowan Sept. c

Improvement Permit by: date 6-24-99 Operation Permit by: Potter date 9.8.99

Authorization to Construct by: date 6-24-99 Existing System Inspection by: date

HEALTH DEPT COPY WHITE OWNER COPY (FINAL) YELLOW OWNER COPY (INITIAL) PINK