IREDELL COUNTY HEALTH DEPARTMENT

STATESVILLE 704-878-5305 300.00 Paid MOORESVILLE 704-664-5281

IMPROVEMENT PERMIT / AUTHORIZATION TO CONSTRUCT / OPERATION PERMIT / EXISTING SYSTEM INSPECTION

PERMIT# 07-2-0800 PIN# 4730-46-6343 DATE March 29, 01

OWNER OR CONTRACTOR C & S Associates PHONE: Business 202-4971 Home

ADDRESS 4474 Lake Dr Sherrills Ford N.C 28673

LOCATION State Park Rd. TR into Meadowglen TL Valley Glen on left near end

SUBDIVISION Meadow Glen BLOCK / SECTION 4 LOT 58 LOT AREA 0.3629 Ac SITE CLASS KS DESIGN FLOW 360 gpd L.T.A.R. 0.3

Septic Tank: 1000 Gallons: STB 1012 Date 10-01-01
Pump Tank: Gallons: PT Date
Pump Make: Model Serial No.
Nitrification Field: No Fields 1 Square Feet 400/600 Linear Feet 200
No Lines 4@50' Trench Width 24", 8"oc Max Trench Bottom Depth 36" Gravel Depth NA

☑ New System ☐ Repair System Type: I II III IV V VI
System Description: ** Gravity PPBPS
Repair System Description: LPPPBS
Maintenance Agreement Required: ☐ Yes ☑ No initially
☐ Slab ☑ Crawl Space ☐ Basement w/plumbing ☐ Basement wo/plumbing


☑ House/Mod. Home No. Bedrooms 3
☐ Mobile Home No. Bathrooms 2
☐ Business No. Employees
☐ Other

Water Supply: ☐ Individual ☑ Public ☐ Community

Comments/Conditions: * 3' wide trenches, 9' on center may be used.
** Exit plumbing at existing spade where tank is shown.

Comments/Conditions 24" WIDTH LINES INSTALLED POLYLOK FILTER & MARKER INSTALLED AS SHOWN

INITIAL SITE SKETCH

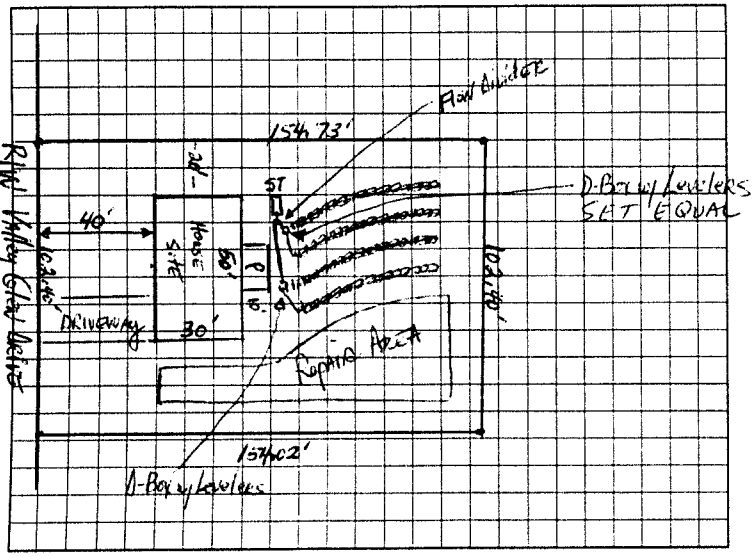

AS BUILT SKETCH

Permit can be suspended or revoked if any false information is supplied toward securing the permit/any unauthorized changes are made to the site/any unauthorized changes are made in the installation of the system. Improvement Permit with plat valid without expiration. Improvement Permit with site plan valid for sixty months. Authorization to Construct is valid for a period equal to that of Improvement Permit - not to exceed sixty months.

Signed: Ginger Cecil date 4/2/01
Improvement Permit by: Mark D. Thomas, PE date 3-30-01
Authorization to Construct by: Steve Hedrick date 6-21-01

Installed by: MITCHELL GRADING
Operation Permit by: Tom Cole RS date 04-04-02
Existing System Inspection by: date

HEALTH DEPT COPY: WHITE OWNER COPY (FINAL): YELLOW OWNER COPY (INITIAL): PINK