101417

IREDELL COUNTY HEALTH DEPARTMENT

STATESVILLE 704-878-5305 MOORESVILLE 704-664-5281

IMPROVEMENT PERMIT / AUTHORIZATION TO CONSTRUCT / OPERATION PERMIT / EXISTING SYSTEM INSPECTION

PERMIT# 08-2-0800 PIN# 4730-48-6343 DATE Dec 20,00

OWNER OR CONTRACTOR C&S Assoc. PHONE. Business 202-4971 Home

ADDRESS 4474 Lake Dr. Sherrills Ford, N.C. 28673

LOCATION State Park 120 TR mto Meadow Glen TL Valley Glen on left

SUBDIVISION Meadow Glen BLOCK / SECTION 4 LOT 57 LOT AREA .037 AC SITE CLASS PS DESIGN FLOW 360gpd L.T.A.R. .3

Septic Tank: 1000 Gallons: STB 1012 Date 6-12-01

Pump Tank: Gallons: PT Date

Pump Make: Model Serial No

Nitrification Field: No Fields 1 Square Feet 600 Linear Feet 200

No Lines 4@50' Trench Width 36" Max Trench Bottom Depth 56" Gravel Depth NA

☑ New System ☐ Repair System Type: I II III IV V VI

System Description: Gravity Panel Block

Repair System Description: Grav LP Panel BK

Maintenance Agreement Required: ☐ Yes ☑ No

☑ House/Mod. Home No. Bedrooms 3

☐ Mobile Home No. Bathrooms 2

☐ Business No. Employees

☐ Other

☐ Slab ☑ Crawl Space ☐ Basement w/plumbing ☐ Basement wo/plumbing


Water Supply: ☐ Individual ☑ Public ☐ Community

Comments/Conditions:

Comments/Conditions CHANGED TANK LOCATION 9-18-01 (LC)
POLYLOK FILTER + MARKER
NEEDS TO RECHECK FIRST LINE SAND IN EACH PANEL & SET DIST BOX SPEED LEVELERS

1"=50'

INITIAL SITE SKETCH

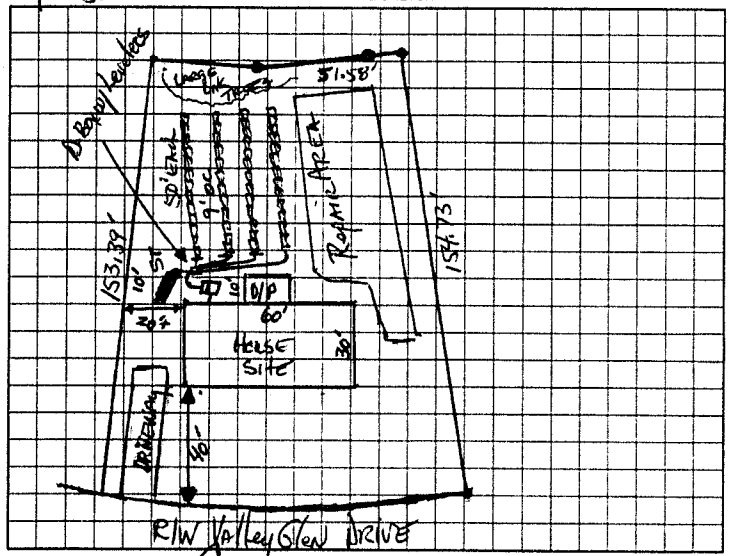

AS BUILT SKETCH

9-20-01 6 SPEED LEVELERS SET & SAND ADDED IN FIRST PANEL OF 4
INSTALLED AS SHOWN

Permit can be suspended or revoked if any false information is supplied toward securing the permit/any unauthorized changes are made to the site/any unauthorized changes are made in the installation of the system. Improvement Permit with plat valid without expiration. Improvement Permit with site plan valid for sixty months. Authorization to Construct is valid for a period equal to that of Improvement Permit – not to exceed sixty months.

Signed: date 12-20-00 Installed by: M. Hyatt Grading

Improvement Permit by: date 12-20-00 Operation Permit by: Jon Cook RS date 9-20-01

Authorization to Construct by: STEVE HEDRICK date 6-21-01 Existing System Inspection by: date

HEALTH DEPT COPY WHITE OWNER COPY (FINAL) YELLOW OWNER COPY (INITIAL) PINK