IREDELL COUNTY HEALTH DEPARTMENT

STATESVILLE 704-878-5305 300.00 Paid MOORESVILLE 704-664-5281

IMPROVEMENT PERMIT / AUTHORIZATION TO CONSTRUCT / OPERATION PERMIT / EXISTING SYSTEM INSPECTION

PERMIT# 19-Z-0900 108157 PIN# 4730-45-6343 DATE Jun 3, 01

OWNER OR CONTRACTOR C & S Associates PHONE Business 202-4771 Home

ADDRESS 4474 Lake Dr Statesville N.C. 28625

LOCATION STATE RD 1131 - TR into Meadowview

SUBDIVISION Meadowview BLOCK / SECTION 4 LOT 80 LOT AREA 1 acre SITE CLASS I DESIGN FLOW 360 GPD L.T.A.R. 3

Septic Tank: 1000 Gallons: STB 825 Date 07/29/02
Pump Tank: 1000 Gallons: PT 302 Date 03/14/02
Pump Make: ZOELLER Model N-137-C Serial No PN-137-0002
Nitrification Field: No Fields 1 Square Feet 400/600 Linear Feet 200
No Lines 5 to 4 x 50 Trench Width 24" Min/36" Max Trench Bottom Depth 36"

✓ New System Repair System Type I II III IV V
System Description 0&1 - LPP BPS
Repair System Description: LPP BPS
Maintenance Agreement Required Yes No initially
Gravel Depth
Slab ✓ Crawl Space Basement w/plumbing Basement wo/plumbing


✓ House/Mod. Home No. Bedrooms 3
Mobile Home No. Bathrooms 2
Business No. Employees
Other

Water Supply: ☐ Individual ✓ Public ☐ Community

Comments/Conditions: OR 36" MIN 9' OC
47'6" x 31" House Plan Approved.


Comments Conditions
- SEPTIC TANK INSTALLED USING MARKER & POLY-LOC FILTER

INITIAL SITE SKETCH

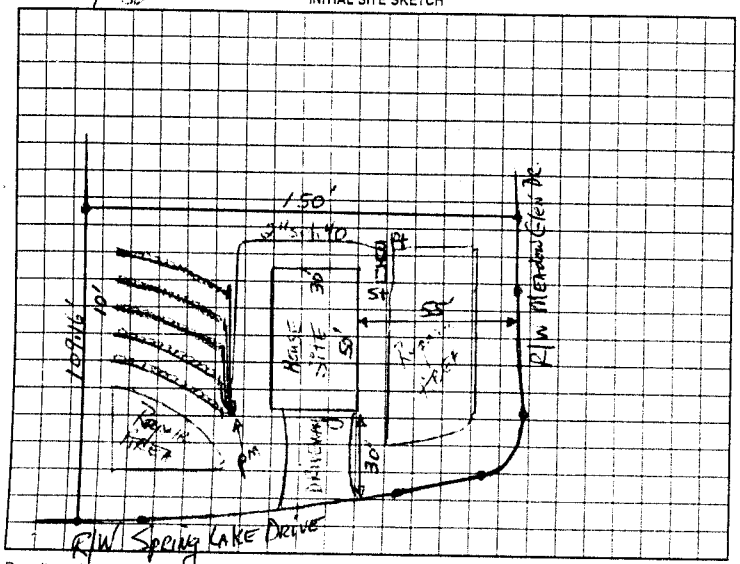

AS BUILT SKETCH

- SYSTEM INSTALLED IN SAME LOCATION BUT CHANGED TO 4 LINES, 50 FEET IN LENGTH.
* NOT TO SCALE
- TANKS CHANGED LOCATION
09/12/02 PM

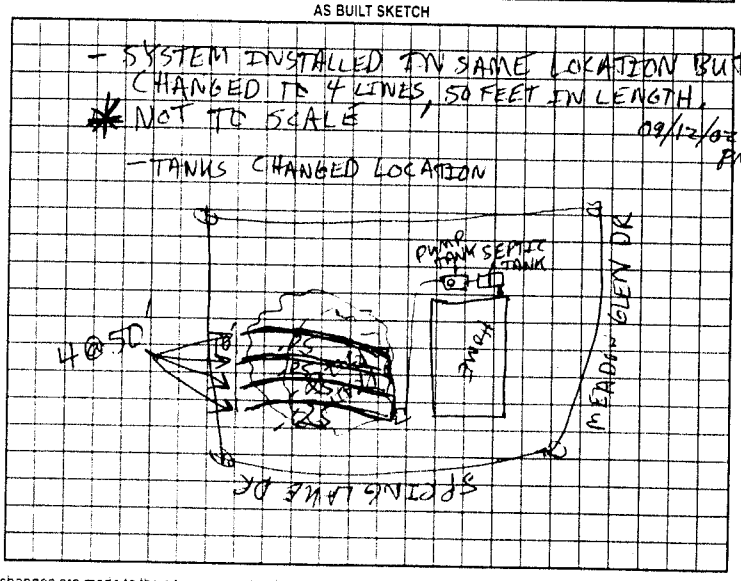

Permit can be suspended or revoked if any false information is supplied toward securing the permit; any unauthorized changes are made to the site any unauthorized changes are made in the installation of the system. Improvement Permit with plat valid without expiration. Improvement Permit with site plan valid for sixty months. Authorization to Construct is valid for a period equal to that of Improvement Permit – not to exceed sixty months.

Signed: La Verne Sweeney date 7-16-01

Improvement Permit by: [signature] date 7-3-01

Authorization to Construct by: William G Johnson date 7-26-02

Installed by ROWAN SEPTIC TANK + DITCHING

Operation Permit by: Patrick Mitchell date 10/11/02

Existing System Inspection by date

HEALTH DEPT. COPY: WHITE OWNER COPY (FINAL): YELLOW OWNER COPY (INITIAL): PINK