BURKE BUILDERS, LLC 94741

IREDELL COUNTY HEALTH DEPARTMENT

STATESVILLE 704-878-5305 MOORESVILLE 704-664-5281

IMPROVEMENT PERMIT / AUTHORIZATION TO CONSTRUCT / OPERATION PERMIT / EXISTING SYSTEM INSPECTION

PERMIT# 09-2-0800 PIN# 4730-48-6343 DATE Dec 20, 00

OWNER OR CONTRACTOR C&S Assoc PHONE: Business Home

ADDRESS 4474 LAKE DR. Sherrills Ford NC 28673

LOCATION State Park Rd TR INTO MEADOWGLEN TL Valley Glen on left

SUBDIVISION MEADOWGLEN BLOCK / SECTION 4 LOT 56 LOT AREA .36AC SITE CLASS PS DESIGN FLOW 360gpd L.T.A.R. .3

Septic Tank: 1000 Gallons: STB 794 Date 1-14-01
Pump Tank: Gallons: PT Date
Pump Make: Model Serial No.
Nitrification Field: No Fields 1 Square Feet 600 Linear Feet 200
No Lines 4@50' Trench Width 36" Max Trench Bottom Depth 36" Gravel Depth NA

☑ New System ☐ Repair System Type: I, II, III, IV, V, VI
System Description: GRAVITY PANEL BLOCK
Repair System Description: LP PANEL BLOCK
Maintenance Agreement Required: ☐ Yes ☑ No (WITH FILL)

☐ House/Mod. Home No. Bedrooms 3
☐ Mobile Home No. Bathrooms 2
☐ Business No. Employees
☐ Other
☐ Slab ☑ Crawl Space ☐ Basement w/plumbing ☐ Basement wo/plumbing


Water Supply: ☐ Individual ☑ Public ☐ Community

Comments/Conditions:

Comments/Conditions SYSTEM INSTALLED AS SHOWN WITH 2ABEL FILTER RISERS

1"=50'

INITIAL SITE SKETCH

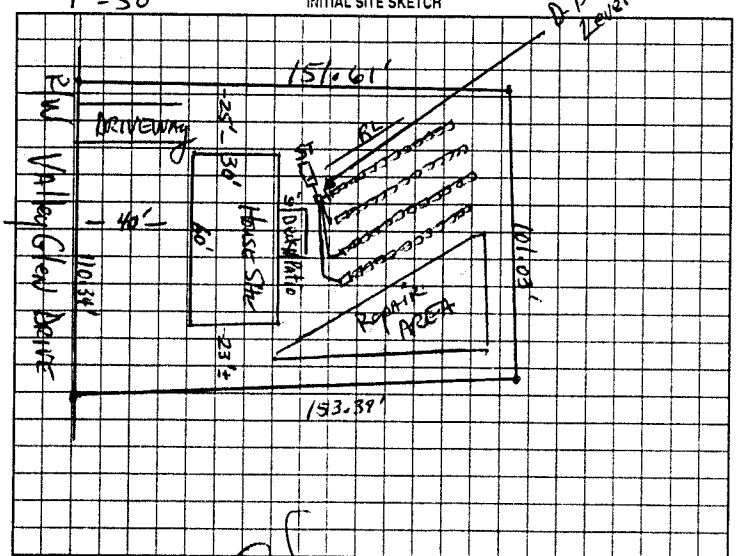

AS BUILT SKETCH

Permit can be suspended or revoked if any false information is supplied toward securing the permit/any unauthorized changes are made to the site/any unauthorized changes are made in the installation of the system. Improvement Permit with plat valid without expiration. Improvement Permit with site plan valid for sixty months. Authorization to Construct is valid for a period equal to that of Improvement Permit – not to exceed sixty months.

Signed: date

Improvement Permit by: date 12-20-00

Authorization to Construct by: STEVE HEARICK date 2-14-01

Installed by: ORBISON BACKHOE

Operation Permit by: date 6-14-01

Existing System Inspection by: date

HEALTH DEPT. COPY WHITE OWNER COPY (FINAL) YELLOW OWNER COPY (INITIAL) PINK