IREDELL COUNTY HEALTH DEPARTMENT

STATESVILLE 704-878-5305 MOORESVILLE 704-664-5281

IMPROVEMENT PERMIT / AUTHORIZATION TO CONSTRUCT / OPERATION PERMIT / EXISTING SYSTEM INSPECTION

PERMIT# TROUTMAN PIN# ~~4730-48-8453~~ 4730.48-6534 DATE 12-4-03

OWNER OR CONTRACTOR BORICE BUILDERS PHONE: Business 704-361-0047 Home 704-662-0647

ADDRESS P.O. BOX 348 MOORESVILLE, NC 28117 LOCATION VALLEY GLEN DR, 3RD LOT ON RT

LOCATION PERTH RD (R) STATE PARK, (R) MEADOW GLEN DR

SUBDIVISION MEADOW GLEN BLOCK / SECTION 4 LOT 64 LOT AREA 0.35 AC SITE CLASS. PS DESIGN FLOW 360 L.T.A.R. .30

Septic Tank: 1,000 Gallons; STB 794 Date 9-20-03

Pump Tank: 1,000 Gallons; PT 27 Date 9-6-03

Pump Make: EPOSILAC Model EPOSILAC Serial No 5204686867

Nitrification Field: No Fields 1 Square Feet ENHANCED Linear Feet 200

No Lines 4 x 50' Trench Width 24" Max Trench Bottom Depth 36" Gravel Depth N/A

[X] New System [ ] Repair System Type: I, II, (III), IV, V, VI

System Description: PUMP 50% REDUCT, RPM

Repair System Description: LP PANEL

Maintenance Agreement Required: [ ] Yes [X] No

[X] House/Mod. Home No. Bedrooms 3

[ ] Mobile Home No. Bathrooms 2½

[ ] Business No. Employees ____

[ ] Other ____


[X] Slab [ ] Crawl Space [ ] Basement w/plumbing [ ] Basement wo/plumbing

Water Supply: [ ] Individual [X] Public [ ] Community

Comments:/Conditions: (1) THIS PERMIT REPLACES PREVIOUSLY ISSUED PERMIT DATED 7-24-03 (2) MAINTAIN SETBACKS

Comments:/Conditions: ZABEL FILTER & RISERS 10'/62 GPM / V'D LINES & TANKS, NEEDS PRESSURE & ELECTRICAL. LINES APPROVED PRIOR TO STATE'S GUIDANCE ON FOAM VS TARSEAL.

INITIAL SITE SKETCH 1" = 30'

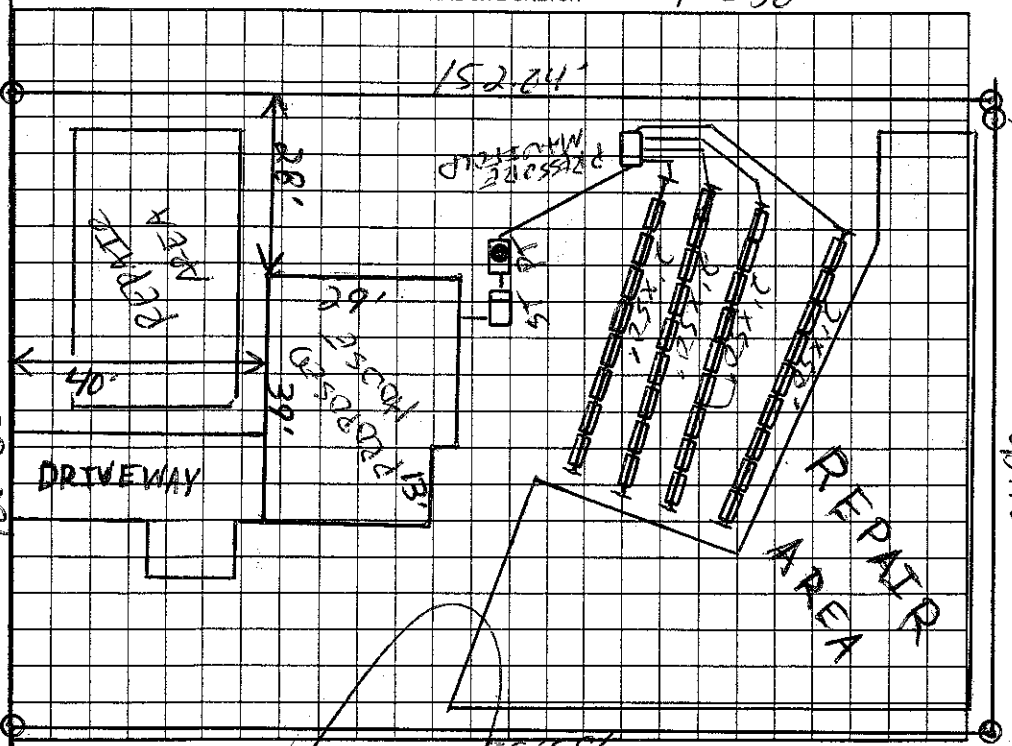

AS BUILT SKETCH

PRESSURE + ELECTRICAL V'D. EVERYTHING OK

Permit can be suspended or revoked if any false information is supplied toward securing the permit/any unauthorized changes are made to the site/any unauthorized changes are made in the installation of the system. Improvement Permit with plat valid without expiration. Improvement Permit with site plan valid for sixty months. Authorization to Construct is valid for a period equal to that of Improvement Permit – not to exceed sixty months.

Signed: ____ date 12/4/03 Installed by: MC CARVER SEPTIC

Improvement Permit by: ____ date 12-4-03 Operation Permit by: ____ date 12-19-03

Authorization to Construct by: ____ date 12-4-03 Existing System Inspection by: ____ date ____

HEALTH DEPT. COPY: WHITE OWNER COPY (FINAL): YELLOW OWNER COPY (INITIAL): PINK