IREDELL COUNTY HEALTH DEPARTMENT

THIS PERMIT VOIDS PREVIOUS ISSUED 5-1-2002

STATESVILLE 704-878-5305 MOORESVILLE 704-664-5281

IMPROVEMENT PERMIT / AUTHORIZATION TO CONSTRUCT / OPERATION PERMIT / EXISTING SYSTEM INSPECTION

PERMIT# TROUTMAN PIN# 4730 48 6772 DATE 6·3·02

OWNER OR CONTRACTOR C & S ASSOCIATES PHONE Business 704·202-4971 Home

ADDRESS 4474 LAKE DRIVE STATESVILLE FORD, NC 28673

LOCATION US 21 S, TR PERTH RD, TR STATE PARK RD, TR MEADOW GLEN DR, LOT ON LEFT AT SPRING LAKE DR

SUBDIVISION MEADOW GLEN BLOCK / SECTION LOT 67 LOT AREA 0.3746 ACRE SITE CLASS PS DESIGN FLOW 360 LTAR 0.30 GPD/FT²

Septic Tank: 1000 Gallons: STB 825 Date 06/13/02
Pump Tank: Gallons: PT Date
Pump Make: Model Serial No
Nitrification Field: No Fields 1 Square Feet 60 to 1200 Linear Feet 200
No Lines SIX Trench Width 24" Max Trench Bottom Depth 36" Gravel Depth SAND 6"

☑ New System ☐ Repair System Type I II (III) IV V
System Description 50% REDUCTION, GRAVITY
Repair System Description 50% REDUCTION, LOW PRESSURE
Maintenance Agreement Required Yes ☑ No


☑ House/Mod Home No Bedrooms 3
☐ Mobile Home No Bathrooms 2
☐ Business No Employees
☐ Other
☐ Slab ☑ Crawl Space ☐ Basement w/plumbing ☐ Basement wo/plumbing

Water Supply: ☐ Individual ☑ Public ☐ Community


Comments/Conditions: ① INSTALL 50% REDUCTION SYSTEM USING 46 PPBPS PANELS IN LINE LENGTHS AS SHOWN ② USE ONE FLOW DIVIDER TEE TO ACHIEVE EQUAL DISTRIBUTION TO EACH SET OF 23 PANELS ③ KEEP SYSTEM MINIMUM 15 FEET FROM TOP OF EMBANKMENT

Comments/Conditions: ④ SEPTIC TANK INSTALLED USING SEPTIC MARKER # POLY-LOK FILTER

SITE SKETCH

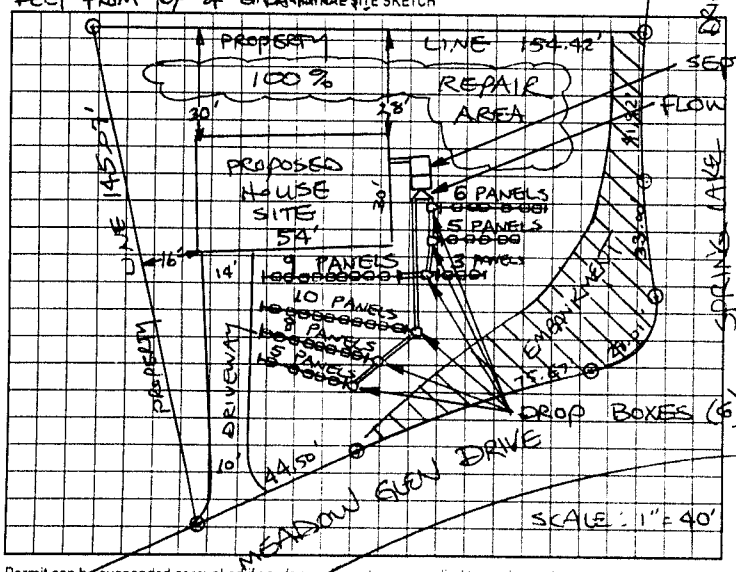

AS BUILT SKETCH

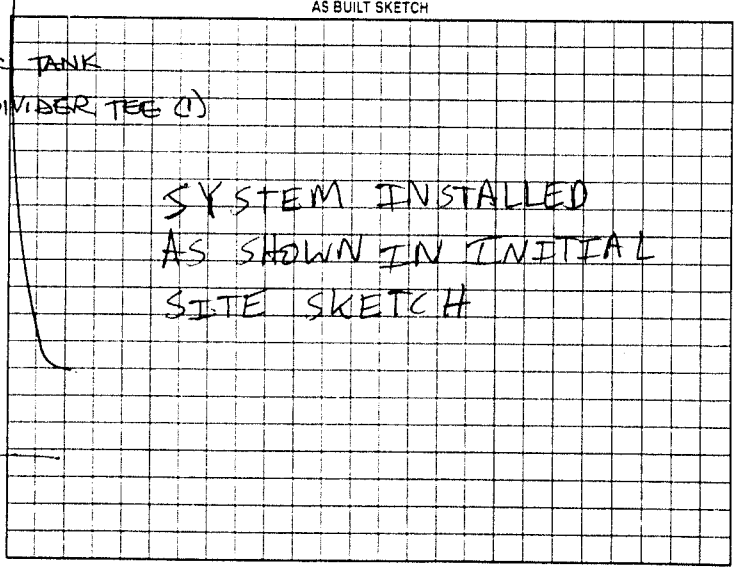

Permit can be suspended or revoked if any false information is supplied toward securing the permit any unauthorized changes are made to the site any unauthorized changes are made in the installation of the system. Improvement Permit with plat valid without expiration. Improvement Permit with site plan valid for sixty months. Authorization to Construct is valid for a period equal to that of Improvement Permit not to exceed sixty months

Signed: Ralph Wright date 6-14-02 Installed by ROWAN SEPTIC

Improvement Permit by: STEVE HEDRICK date 6·3·02 Operation Permit by Patrick Mitchell date 08/12/02

Authorization to Construct by: STEVE HEDRICK date 6·3·02 Existing System Inspection by: date

HEALTH DEPT COPY WHITE OWNER COPY (FINAL) YELLOW OWNER COPY (INITIAL) PINK