IREDELL COUNTY HEALTH DEPARTMENT

STATESVILLE 704-878-5305 MOORESVILLE 704-664-5281

IMPROVEMENT PERMIT / AUTHORIZATION TO CONSTRUCT / OPERATION PERMIT / EXISTING SYSTEM INSPECTION

PERMIT# 11-7-6998326 PIN# 4730486413 DATE 8/5/99

OWNER OR CONTRACTOR Spears Construction PHONE: Business (704) 361-7518 Home

ADDRESS 607 Anderson Ave Salisbury NC 28144

LOCATION State Park Rd TL (B4 Perth Rd) Meadow Glen Dr TL Whitney LN

SUBDIVISION Meadow Glen BLOCK / SECTION LOT 49 LOT AREA .3459 Acres SITE CLASS PS DESIGN FLOW 360gpd T.A.R. .3

Septic Tank: 1000 Gallons; STB 825 Date 6-15-99
Pump Tank: 1000 Gallons; PT 302 Date 8-1-99
Pump Make: Zoeller Model N137 Serial No.
Nitrification Field: No Fields | Square Feet 900' Linear Feet 300'
No Lines 4@75' Trench Width 36" Max Trench Bottom Depth 36"

[X] New System [ ] Repair System Type: I, II, III, IV, V, VI
System Description: Pump (pm) to 25% Reduction
Repair System Description: Gravity/Pump Paved Block
Maintenance Agreement Required: [ ] Yes [X] No


[X] House/Mod. Home [ ] Mobile Home [ ] Business [ ] Other
No. Bedrooms 3 No. Bathrooms 2 No. Employees
Gravel Depth N/A [X] Slab [ ] Crawl Space [ ] Basement w/plumbing [ ] Basement wo/plumbing

Water Supply: [ ] Individual [X] Public [ ] Community

Comments/Conditions: Keep Septic System at least 10' from PL & 5' from House

Comments/Conditions:
9-1 checked Tanks & Lines only no
9-20 Lines Pressured Checked OK J

INITIAL SITE SKETCH Scale 1"=50'

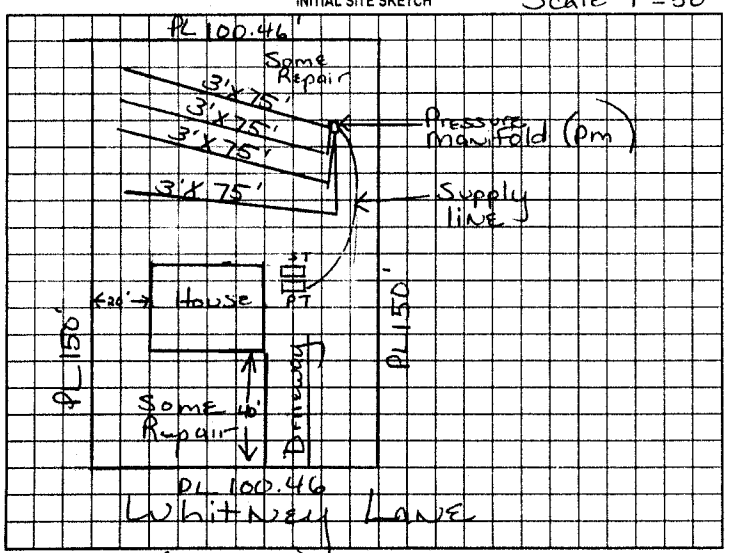

AS BUILT SKETCH

Permit can be suspended or revoked if any false information is supplied toward securing the permit/any unauthorized changes are made to the site/any unauthorized changes are made in the installation of the system. Improvement Permit with plan valid without expiration. Improvement Permit with site plan valid for sixty months. Authorization to Construct is valid for a period equal to that of Improvement Permit – not to exceed sixty months.

Signed: date 8-6-99 Installed by: Rowan Septic

Improvement Permit by: Marianne Dotson R.S. date 8/5/99 Operation Permit by: C Potter date Sept 20 99

Authorization to Construct by: Marianne Dotson R.S. date 8/5/99 Existing System Inspection by: date

HEALTH DEPT COPY WHITE OWNER COPY (FINAL) YELLOW OWNER COPY (INITIAL) PINK