C+S ASSOC.

DO 185026

THIS PERMIT VOIDS PREVIOUS ISSUED 1-31-01

IREDELL COUNTY HEALTH DEPARTMENT

STATESVILLE 704-878-5305 MOORESVILLE 704-664-5281

IMPROVEMENT PERMIT / AUTHORIZATION TO CONSTRUCT / OPERATION PERMIT / EXISTING SYSTEM INSPECTION

PERMIT# 094740 PIN# 4730 48 6343 DATE 5-22-01

OWNER OR CONTRACTOR BURKE BUILDERS, LLC PHONE: Business (704) 361-0047 Home

ADDRESS P.O. BOX 3481 MOORESVILLE NC 28117

LOCATION STATE PARK ROAD, TR MEADOW GLEN TL VALLEY GLEN, LOT # 55 ON LEFT

SUBDIVISION MEADOW GLEN BLOCK / SECTION IV LOT 55 LOT AREA 0.3538 ACRE SITE CLASS PS DESIGN FLOW 360 L.T.A.R. 0.30 GPD/FT²

Septic Tank: 1000 Gallons: STB 794 Date 4-17-01

Pump Tank: 1000 Gallons: PT 238 Date 4-22-01

Pump Make: GOULDS Model ~~DO~~ 185026 Serial No WE05111H

Nitrification Field: No Fields 1 Square Feet EQ. TO 1200 Linear Feet 200

No Lines FOUR Trench Width 24" Max Trench Bottom Depth 36" Gravel Depth SAND 6"

☑ New System ☐ Repair System Type: I, II, ☑ III, IV, V, VI

System Description: 50% REDUCTION, PUMP

Repair System Description: 50% REDUCTION, LOW-PRES.

Maintenance Agreement Required: ☐ Yes ☑ No

☑ Slab ☐ Crawl Space ☐ Basement w/plumbing ☐ Basement wo/plumbing

☑ House/Mod. Home No. Bedrooms 3

☐ Mobile Home No. Bathrooms 2

☐ Business No. Employees

☐ Other

Water Supply: ☐ Individual ☑ Public ☐ Community


Comments/Conditions: ① INSTALL 50% REDUCTION SYSTEM USING 44 PPBPS PANELS IN 4 EQUAL LENGTH LINES. ② SEE ATTACHED SHEETS FOR PUMP AND PRESSURE MANIFOLD REQUIREMENTS.

Comments/Conditions: ZABEL FILTER WITH RISERS

LINES & PRESSURE CHECKED 6-18-01 NEED ELECTRICAL (C)

INITIAL SITE SKETCH

SCALE: 1" = 30'

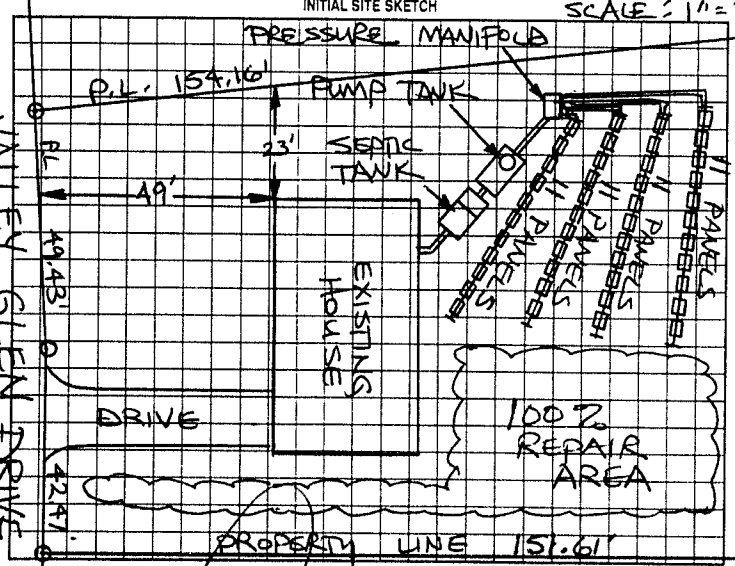

AS BUILT SKETCH

SYSTEM INSTALLED ACCORDING TO INITIAL SITE SKETCH

Permit can be suspended or revoked if any false information is supplied toward securing the permit/any unauthorized changes are made to the site/any unauthorized changes are made in the installation of the system. Improvement Permit with plat valid without expiration. Improvement Permit with site plan valid for sixty months. Authorization to Construct is valid for a period equal to that of Improvement Permit – not to exceed sixty months.

Signed: _____ date 5/22/01 Installed by: ORBISON

Improvement Permit by: STEVE HEDRICK date 5-22-01 Operation Permit by: STEVE HEDRICK date 7-17-01

Authorization to Construct by: STEVE HEDRICK date 5-22-01 Existing System Inspection by: _____ date _____

HEALTH DEPT COPY: WHITE OWNER COPY (FINAL): YELLOW OWNER COPY (INITIAL): PINK