IREDELL COUNTY HEALTH DEPARTMENT

THIS PERMIT VOIDS PREVIOUS ISSUED JULY 2, 2001

STATESVILLE 704-878-5305 MOORESVILLE 704-664-5281

IMPROVEMENT PERMIT / AUTHORIZATION TO CONSTRUCT / OPERATION PERMIT / EXISTING SYSTEM INSPECTION

PERMIT# TROUTMAN PIN# 4730-48-7529 DATE 6-17-02

OWNER OR CONTRACTOR BURKE BUILDERS, LLC PHONE Business 704-361-0047 Home

ADDRESS P.O. BOX 3481, MOORESVILLE, NC 28117

LOCATION US 21 S TR, PERTH, TR STATE PARK, TR MEADOW GLEN, TL VALLEY GLEN, 2ND ON RIGHT

SUBDIVISION MEADOW GLEN BLOCK / SECTION IV LOT 65 LOT AREA 0.37 ACRE SITE CLASS PS DESIGN FLOW 360 LTAR 0.30 GPD/FT²

Septic Tank: 1000 Gallons STB 1012 Date 06/04/02
Pump Tank: Gallons PT Date
Pump Make: Model Serial No
Nitrification Field: No Fields 1 Square Feet EQ. TO 1200 Linear Feet 200
No Lines FOUR Trench Width 24" Max Trench Bottom Depth 36 Gravel Depth SAND 6"

New System Repair System Type I II III IV V
System Description 50% REDUCTION, GRAVITY
Repair System Description 50% REDUCTION, LOW PRESSURE
Maintenance Agreement Required Yes No Other
Slab Crawl Space Basement w/plumbing Basement wo/plumbing


House/Mod Home No Bedrooms 3
Mobile Home No Bathrooms 2
Business No Employees

Water Supply: Individual Public Community


Comments/Conditions: INSTALL 50% REDUCTION SYSTEM USING 44 PPBPS PANELS IN FOUR EQUAL LENGTH LINES AS SHOWN

Comments/Conditions: -SEPTIC TANK INSTALLED USING SEPTIC MARKER + TUFF TIGHT FILTER

INITIAL SITE SKETCH

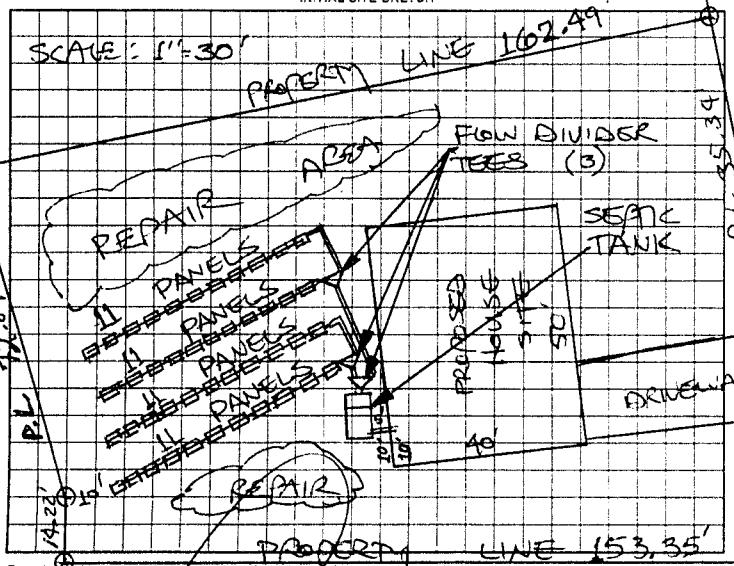

AS BUILT SKETCH

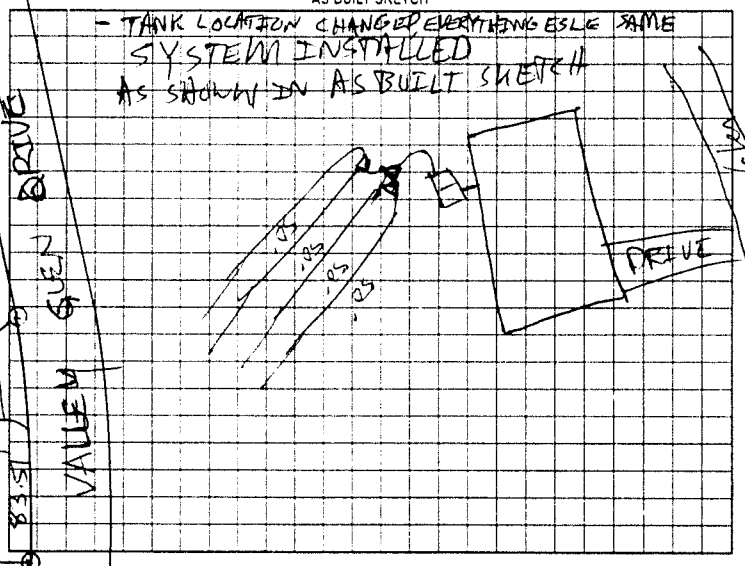

Permit can be suspended or revoked if any false information is supplied toward securing the permit any unauthorized changes are made to the site any unauthorized changes are made in the installation of the system. Improvement Permit with plat valid without expiration. Improvement Permit with site plan valid for sixty months. Authorization to Construct is valid for a period equal to that of Improvement Permit but not to exceed sixty months.

Signed: date 6/18/02 Installed by RICHARD ABERNATHY

Improvement Permit by: STEVE HEDRICK date 6-17-02 Operation Permit by date 09/06/02

Authorization to Construct by: STEVE HEDRICK date 6-17-02 Existing System Inspection by: date

HEALTH DEPT COPY WHITE OWNER COPY (FINAL) YELLOW OWNER COPY (INITIAL) PINK