125459

# IREDELL COUNTY HEALTH DEPARTMENT

STATESVILLE 704-878-5305 (a) MOORESVILLE 704-664-5281

## IMPROVEMENT PERMIT / AUTHORIZATION TO CONSTRUCT / OPERATION PERMIT / EXISTING SYSTEM INSPECTION

PERMIT# TROUTMAN PIN# 4730-48-8003 DATE 11-12-04

OWNER OR CONTRACTOR BRIAN E. ROBINETT CONSTRUCTION PHONE: Business (704) 201-9172 Home

ADDRESS 113 WEDGEVIEW WAY STATESVILLE NC 28677

LOCATION 215 TR STATE PARK RD TR MEADOW GLEN TL PARK VISTA LOT ON LT

SUBDIVISION MEADOW GLEN BLOCK / SECTION II LOT 43 LOT AREA 0.70 SITE CLASS. PS DESIGN FLOW 360 L.T.A.R. 0.30 gpd/ft²

Septic Tank: 1000 Gallons; STB 760 Date 11-13-04
Pump Tank: 1000 Gallons; PT 363 Date 2-8-05
Pump Make: ZOELLER Model 151 Serial No.
Nitrification Field: No Fields 1 Square Feet 1200 Linear Feet 300
No Lines 3 Trench Width 36" Max Trench Bottom Depth 36" Gravel Depth N/A

☑ New System ☐ Repair System Type: I, II, (III), IV, V, VI
System Description: PUMP 25% REDUCTION
Repair System Description: LP PANEL 50% RED.
Maintenance Agreement Required: ☐ Yes ☑ No


☑ House/Mod. Home No. Bedrooms 3
☐ Mobile Home No. Bathrooms
☐ Business No. Employees
☐ Other
☐ Slab ☑ Crawl Space ☐ Basement w/plumbing ☐ Basement wo/plumbing

Water Supply: ☐ Individual ☑ Public ☐ Community


Comments:/Conditions (1) INSTALL ON CONTOUR (2) DO NOT CUT FOR POSITIVE DRAINAGE SETBACKS (3) MUST BACKFILL OR PERMIT WILL BE VOID (4) NO FOUNDATION DRAIN AROUND HOUSE OR PERMIT WILL BE VOID

Comments:/Conditions: (5) MUST DIVERT SURFACE WATER AT LEAST 25' UPSLOPE FROM SEPTIC TANKS (6) MUST SLEEVE SUPPLY LINE W/ DUCTILE IRON PIPE OR KEEP SUPPLY LINE 30" BELOW SOIL SURFACE. (7) MUST REMOVE GRAVEL PAD OVER SYSTEM.

INITIAL SITE SKETCH

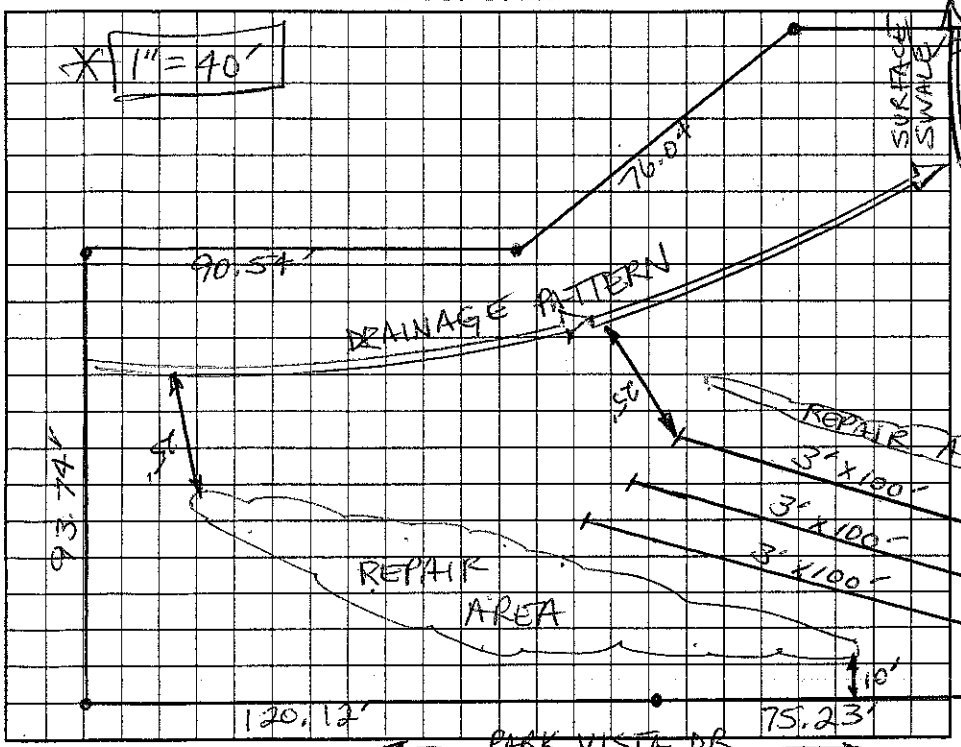


AS BUILT SKETCH

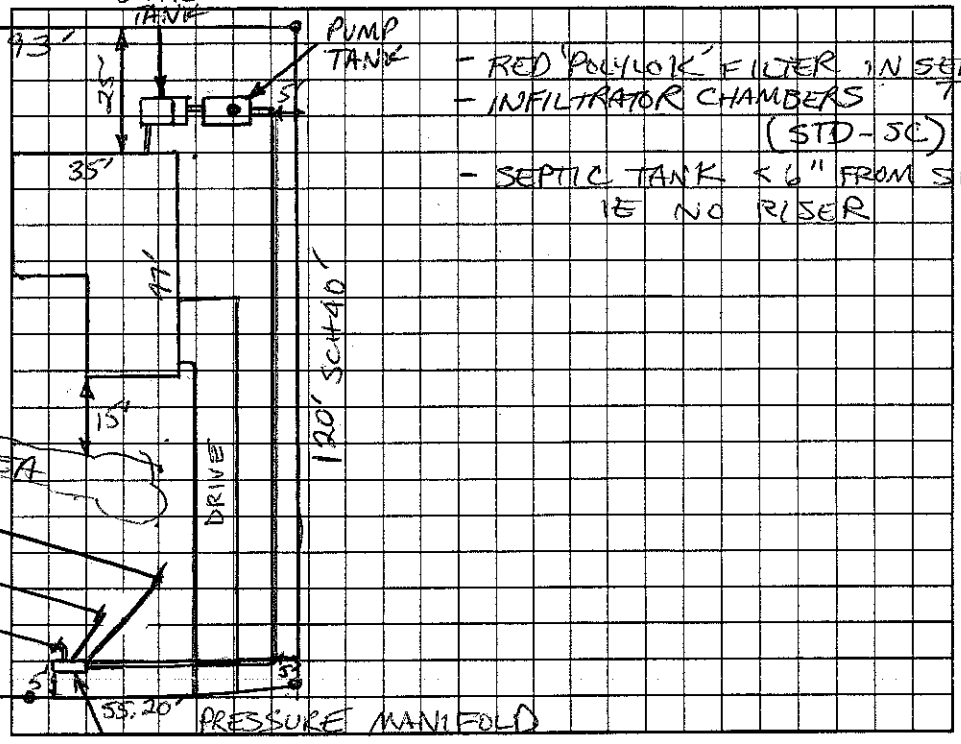


- RED 'POLYLOK' FILTER IN SEPTIC TANK
- INFILTRATOR CHAMBERS (STD-5C)
- SEPTIC TANK 6" FROM SURFACE IF NO RISER

Permit can be suspended or revoked if any false information is supplied toward securing the permit/any unauthorized changes are made to the site/any unauthorized changes are made in the installation of the system. Improvement Permit with plat valid without expiration. Improvement Permit with site plan valid for sixty months. Authorization to Construct is valid for a period equal to that of Improvement Permit – not to exceed sixty months.

Signed: [signature] date 11/15/04 Installed by: SAMMY REAVIS

Improvement Permit by: [signature] date 11-12-04 Operation Permit by: STEVE HEDRICK date 4-29-05

Authorization to Construct by: [signature] date 11-12-04 Existing System Inspection by: date

HEALTH DEPT. COPY: WHITE OWNER COPY (FINAL): YELLOW OWNER COPY (INITIAL): PINK