IREDELL COUNTY HEALTH DEPARTMENT

STATESVILLE 704-878-5305 MOORESVILLE 704-664-5281

IMPROVEMENT PERMIT / AUTHORIZATION TO CONSTRUCT / OPERATION PERMIT / EXISTING SYSTEM INSPECTION

PERMIT# 12-2-699 PIN# 4730-48-6413 DATE July 30, '99

OWNER OR CONTRACTOR Jason Construction / C&S Assoc. PHONE: Business _____ Home _____

ADDRESS 607 Anderson Ave, Salisbury 28144 / 904 Silver St, Thomasville 27360

LOCATION Tyntman, Perth Road South TR State Park Rd. TR Meadow Glen Drive TL Whitney Lane 3rd on Right

SUBDIVISION Meadow Glen BLOCK / SECTION _____ LOT 50 LOT AREA .3444 Ac. SITE CLASS. PS DESIGN FLOW 360gpd L.T.A.R. .3

Septic Tank: 1000 Gallons; STB 825 Date 3 17 00
Pump Tank: 1000 Gallons; PT 302 Date 4 28 00
Pump Make: Zoeller Model N98-B Serial No. 020.60417
Nitrification Field: No Fields 1 Square Feet 900 Linear Feet 300
No Lines 4@75 Trench Width 36" Max Trench Bottom Depth 36"

☑ New System ☐ Repair System Type: I, II, III, IV, V, VI
System Description: PM- Innovative -35% Reduction
Repair System Description: LP Panel Block
Maintenance Agreement Required: ☐ Yes ☑ No initially
Gravel Depth NA ☑ Slab ☐ Crawl Space ☐ Basement w/plumbing ☐ Basement wo/plumbing

☑ House/Mod. Home No. Bedrooms 3
☐ Mobile Home No. Bathrooms 2
☐ Business No. Employees _____
☐ Other _____


Water Supply: ☐ Individual ☑ Public ☐ Community

Comments:/Conditions: * ONE INSPECTION PORT PER LATERAL.

Comments:/Conditions 6.9-00 System installed as Designed
6.12- Pump installed system cycled pressure set.
6.27 W/Rivig CK Alarm CK JK

1"=50'

INITIAL SITE SKETCH

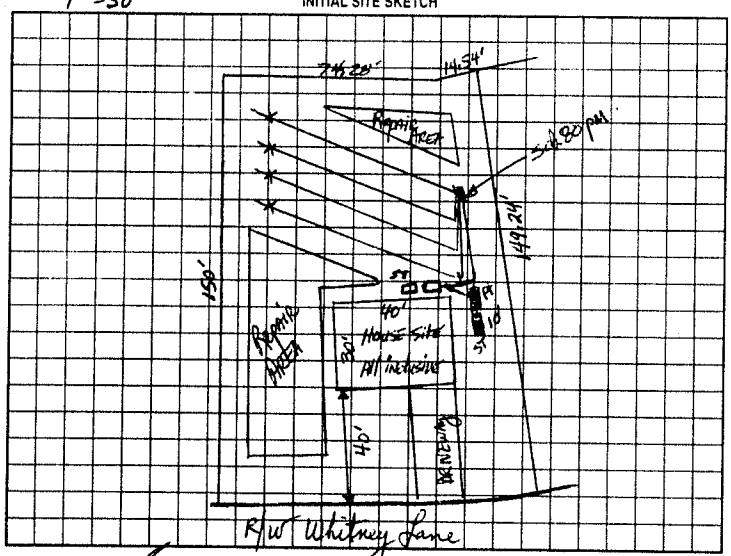

AS BUILT SKETCH

Permit can be suspended or revoked if any false information is supplied toward securing the permit/any unauthorized changes are made to the site/any unauthorized changes are made in the installation of the system. Improvement Permit with plat valid without expiration. Improvement Permit with site plan valid for sixty months. Authorization to Construct is valid for a period equal to that of Improvement Permit – not to exceed sixty months.

Signed: _____ date 8-2-99 Installed by: Wayne Clontz

Improvement Permit by: _____ date 7-30-99 Operation Permit by: _____ date June 27 2000

Authorization to Construct by: _____ date 7-30-99 Existing System Inspection by: _____ date _____

HEALTH DEPT COPY WHITE OWNER COPY (FINAL) YELLOW OWNER COPY (INITIAL) PINK