IREDELL COUNTY HEALTH DEPARTMENT

THIS PERMIT VOIDS PREVIOUS ISSUED 1-2-04

STATESVILLE 704-878-5305 (C1) MOORESVILLE 704-664-5281

IMPROVEMENT PERMIT / AUTHORIZATION TO CONSTRUCT / OPERATION PERMIT / EXISTING SYSTEM INSPECTION

PERMIT# ~~TROUTMAN~~ 118909 PIN# 4730-48-8453 DATE 1-20-04

OWNER OR CONTRACTOR GRAYSON O. STAMEY PHONE: Business 704-400-9643 Home 704-202-1876

ADDRESS 108 WESTFIELD PLAZA, MOORESVILLE NC 28115

LOCATION PERTH ROAD TO STATE PARK RD, TR MEADOW GLEN DR, TL VALLEY GLEN DR, 2ND LOT ON LEFT

SUBDIVISION MEADOW GLEN BLOCK / SECTION 4 LOT 54 LOT AREA 0.3448 ACRE SITE CLASS. PS DESIGN FLOW 300 L.T.A.R. 0.25 GPD/FT²

Septic Tank: 1000 Gallons; STB 55 Date 1-10-04

Pump Tank: ____ Gallons; PT ____ Date ____

Pump Make: ____ Model ____ Serial No. ____

Nitrification Field: No Fields 1 Square Feet EQ. TO 1440 Linear Feet 360

No Lines SIX Trench Width 36" Max Trench Bottom Depth 36" Gravel Depth N/A

☑ New System ☐ Repair System Type: I, II, III, IV, V, VI

System Description: 25% REDUCTION, GRAVITY

Repair System Description: 50% REDUCTION, LOW PRESSURE

Maintenance Agreement Required: ☐ Yes ☑ No

☑ House/Mod. Home ☐ Mobile Home ☐ Business ☐ Other

No. Bedrooms 3 No. Bathrooms 2½ No. Employees ____


☐ Slab ☑ Crawl Space ☐ Basement w/plumbing ☐ Basement wo/plumbing

Water Supply: ☐ Individual ☑ Public ☐ Community

Comments:/Conditions: INSTALL 25% REDUCTION SYSTEM IN SIX EQUAL LENGTH LINES. LOCATE PLUMBING STUB-OUT AS SHALLOW AS POSSIBLE TO ACCOMODATE GRAVITY-FED LINES NO DEEPER THAN 36".

Comments:/Conditions: SEPTIC TANK WITH MARKER INSTALLED USING "POLYLOK" FILTER

INITIAL SITE SKETCH SCALE: 1" = 30'

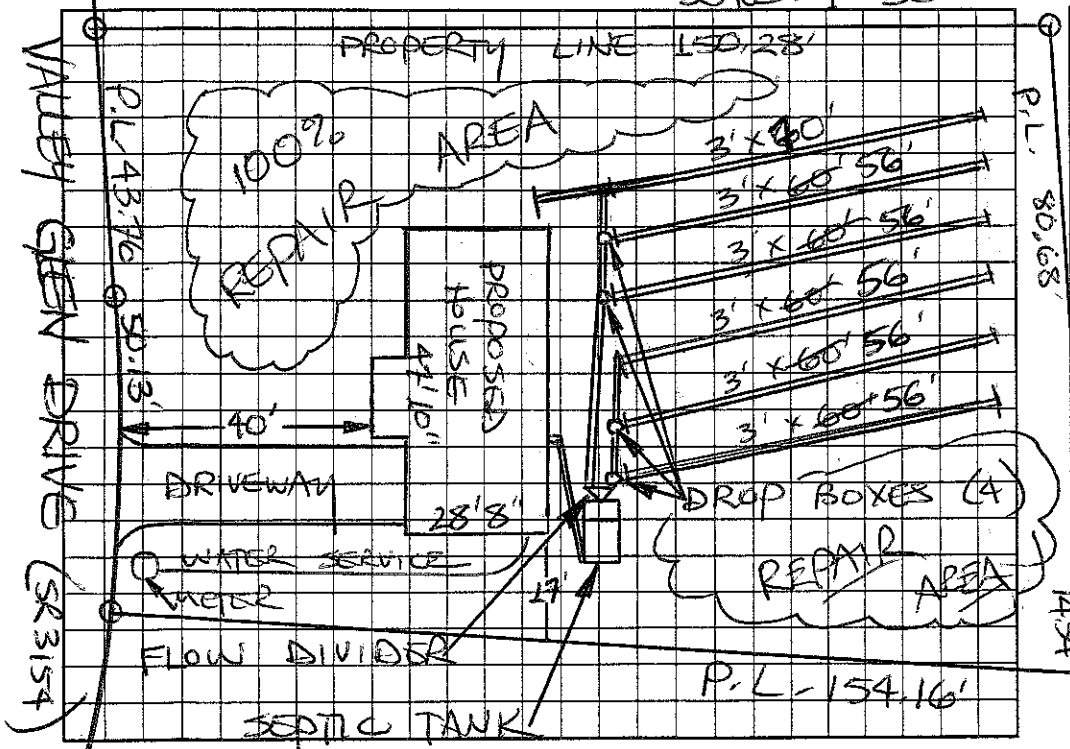

AS BUILT SKETCH

SYSTEM INSTALLED ACCORDING TO INITIAL SITE SKETCH

Permit can be ~~suspended or revoked if any false~~ information is supplied toward securing the permit/any unauthorized changes are made to the site/any unauthorized changes are made in the installation of the system. Improvement Permit with plat valid without expiration. Improvement Permit with site plan valid for sixty months. Authorization to Construct is valid for a period equal to that of Improvement Permit – not to exceed sixty months.

Signed: ____ date ____

Improvement Permit by: STEVE HEDRICK date 1-20-04

Authorization to Construct by: STEVE HEDRICK date 1-20-04

Installed by: ELDON FLOYD / CORINTHIAN BUILDERS

Operation Permit by: STEVE HEDRICK date 4-23-04

Existing System Inspection by: ____ date ____

HEALTH DEPT. COPY: WHITE OWNER COPY (FINAL): YELLOW OWNER COPY (INITIAL): PINK