THIS PERMIT VOIDS PREVIOUS ISSUED 7-2-01

IREDELL COUNTY HEALTH DEPARTMENT

STATESVILLE 704-878-5305 MOORESVILLE 704-664-5281

IMPROVEMENT PERMIT / AUTHORIZATION TO CONSTRUCT / OPERATION PERMIT / EXISTING SYSTEM INSPECTION

PROGRAM PERMIT# 11-2-0800 (704374) PIN# 4730-48-6343 DATE 1-10-02

OWNER OR CONTRACTOR C & S ASSOCIATES PHONE Business 704-202-4971 Home

ADDRESS 4474 LAKE DRIVE, SHERRILLS FORD, NC 28673

LOCATION US 21 S, TR PERTH RD, TR STATE PARK RD, TR MEADOW GLEN DR, TL VALLEY GLEN DR, 1ST LOT ON RIGHT

SUBDIVISION MEADOW GLEN BLOCK / SECTION IV LOT 66 LOT AREA 0.36 ACRE SITE CLASS PS DESIGN FLOW 360 LTAR 0.30 GPD/FT²

Septic Tank: 1000 Gallons STB $825 Date 12-19-01
Pump Tank: Gallons PT Date
Pump Make: Model Serial No
Nitrification Field: No Fields 1 Square Feet EQ to 1200 Linear Feet 200
No Lines FOUR Trench Width 24" Max Trench Bottom Depth 36" ~~Gravel~~ Depth SAND 6"

✓ New System Repair System Type I II (III) IV V VI
System Description 50% REDUCTION, GRAVITY
Repair System Description 50% REDUCTION, LOW-PRESSURE
Maintenance Agreement Required Yes ✓ No
☐ Slab ✓ Crawl Space Basement w/plumbing ☐ Basement wo/plumbing


✓ House/Mod Home No Bedrooms 3
☐ Mobile Home No. Bathrooms 2
☐ Business No Employees
☐ Other

Water Supply: ☐ Individual ✓ Public ☐ Community

Comments/Conditions: INSTALL 50% REDUCTION SYSTEM AS FLAGGED USING 44 PPBPS PANELS IN FOUR EQUAL LENGTH LINES

Comments/Conditions: Polylok filter Installed

INITIAL SITE SKETCH

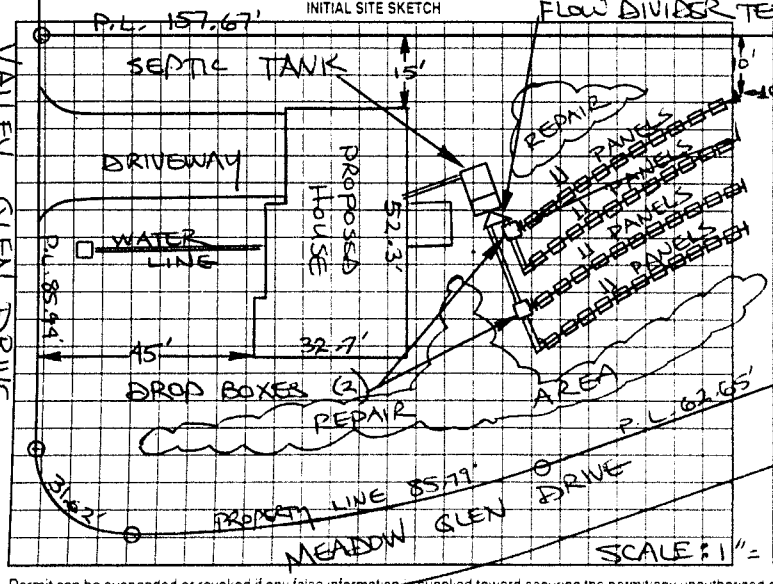

AS BUILT SKETCH

Installed as Shown Per Initial Site Sketch.

Permit can be suspended or revoked if any false information is supplied toward securing the permit; any unauthorized changes are made to the site any unauthorized changes are made in the installation of the system. Improvement Permit with plat valid without expiration. Improvement Permit with site plan valid for sixty months. Authorization to Construct is valid for a period equal to that of Improvement Permit - not to exceed sixty months.

Signed: Regina K Cecil date 1/14/02 Installed by Rowan Septic

Improvement Permit by: STEVE HEDRICK date 1-10-02 Operation Permit by: William O. Johnson date 3/5/02

Authorization to Construct by: STEVE HEDRICK date 1-10-02 Existing System inspection by: date

HEALTH DEPT COPY WHITE OWNER COPY (FINAL) YELLOW OWNER COPY (INITIAL) PINK