IREDELL COUNTY HEALTH DEPARTMENT

STATESVILLE 704-878-5305 MOORESVILLE 704-664-5281

IMPROVEMENT PERMIT / AUTHORIZATION TO CONSTRUCT / OPERATION PERMIT / EXISTING SYSTEM INSPECTION

PERMIT# 13-2-699 / 8279 PIN# 4730486913 DATE May 24, 2000

OWNER OR CONTRACTOR Ray Short PHONE: Business Home

ADDRESS

LOCATION State Park Rd TR Meadowview Dr TR Park Vista 2nd Lot on Right

SUBDIVISION Meadowview BLOCK / SECTION LOT 51 LOT AREA .34± Ac SITE CLASS PS DESIGN FLOW 360 gpd L.T.A.R. .3

Septic Tank: 1000 Gallons; STB 825 Date 3 10 00
Pump Tank: Gallons; PT Date
Pump Make: Model Serial No.
Nitrification Field: No Fields 2 Square Feet 900 Linear Feet 300
No Lines 3+3 Trench Width 36" Max Trench Bottom Depth 36" Gravel Depth NA

☑ New System ☐ Repair System Type: I, II, III, IV, V, VI
System Description: Gravity Innovative-25% Red.
Repair System Description: Similar Type
Maintenance Agreement Required: ☐ Yes ☑ No


☑ House/Mod. Home No. Bedrooms 3
☐ Mobile Home No. Bathrooms 2
☐ Business No. Employees
☐ Other
☑ Slab ☐ Crawl Space ☐ Basement w/plumbing ☐ Basement wo/plumbing

Water Supply: ☐ Individual ☑ Public ☐ Community


Comments/Conditions: ① ONE inspection port per Lateral, set flush with finished grade. This permit replaces permit issued 7-30-99

Comments/Conditions: 5-26 Lines installed as shown
5-30 Flow Divider, filter & Both D Boxes inspected
Lateral inspection ports installed. Not to grade

INITIAL SITE SKETCH

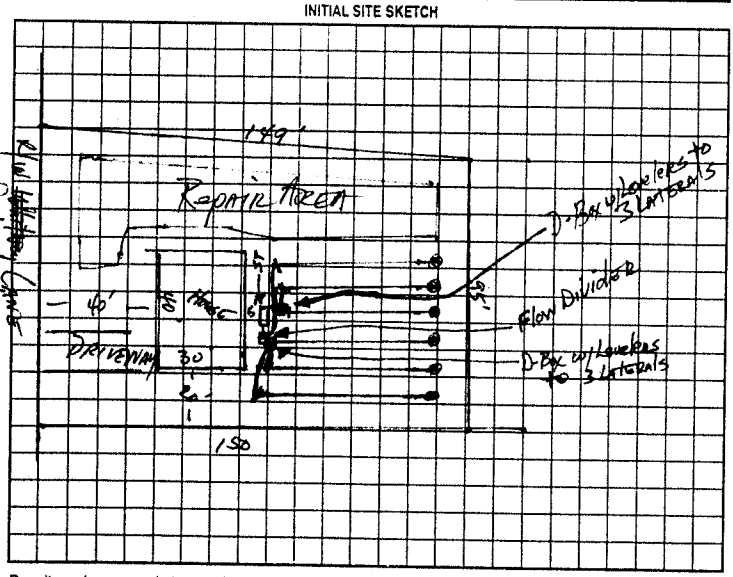

AS BUILT SKETCH

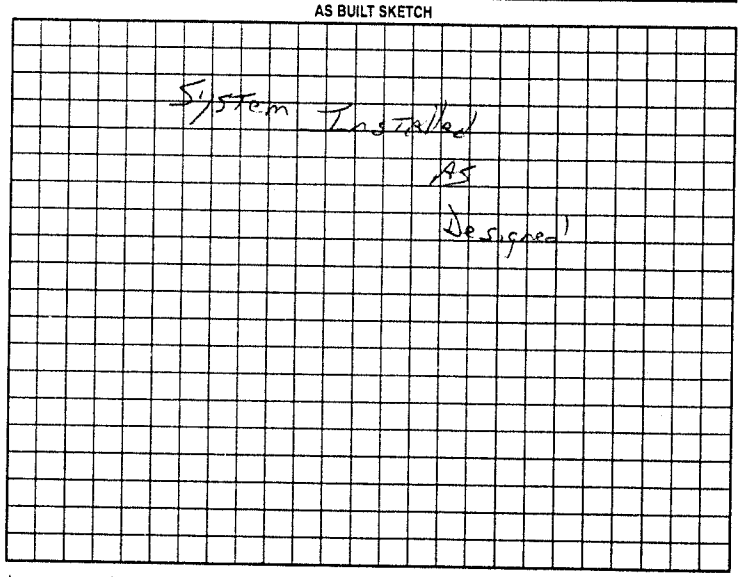

Permit can be suspended or revoked if any false information is supplied toward securing the permit/any unauthorized changes are made to the site/any unauthorized changes are made in the installation of the system. Improvement Permit with plat valid without expiration. Improvement Permit with site plan valid for sixty months. Authorization to Construct is valid for a period equal to that of Improvement Permit – not to exceed sixty months.

Signed: Ray Short for TR Hyatt date 5/26/00
Improvement Permit by: date 5-24-00
Authorization to Construct by: date 5-24-00

Installed by: Wayne County
Operation Permit by: date May 30 2000
Existing System Inspection by: date

HEALTH DEPT. COPY: WHITE OWNER COPY (FINAL): YELLOW OWNER COPY (INITIAL): PINK