FABER- WHITE HEAD HOMES 94660

IREDELL COUNTY HEALTH DEPARTMENT

STATESVILLE 704-878-5305 300.00 Paid MOORESVILLE 704-664-5281

IMPROVEMENT PERMIT / AUTHORIZATION TO CONSTRUCT / OPERATION PERMIT / EXISTING SYSTEM INSPECTION

PERMIT# 22-2-0900 PIN# 4730-48-6343 DATE Jan 17, 01

OWNER OR CONTRACTOR C&S Assoc. PHONE. Business 202-4971 Home

ADDRESS 4474 Lake Dr. Sherrills Ford N.C. 28673

LOCATION State Park Rd TR. into Meadow Glen to end Bear left on Shenandoah Loop on left

SUBDIVISION Meadow Glen BLOCK / SECTION II LOT 84 LOT AREA .50 Ac SITE CLASS PS DESIGN FLOW 360gpd L.T.A.R. .3

Septic Tank: 1000 Gallons: STB 825 Date 4-25-01
Pump Tank: 1000 Gallons: PT 302 Date 4-20-01
Pump Make: MERCER Model N137 Serial No
Nitrification Field: No Fields 1 Square Feet 900 Linear Feet 300
No Lines 5 Trench Width 36" Max Trench Bottom Depth ~34" Gravel Depth NA

☑ New System ☐ Repair System Type: I. II III IV V VI
System Description: PM - INNOVATIVE-25% Red.
Repair System Description: ~~Same~~ 50% RED, PRESS.
Maintenance Agreement Required: ☐ Yes ☑ No
☐ Slab ☑ Crawl Space ☐ Basement w/plumbing ☐ Basement wo/plumbing


☑ House/Mod. Home No. Bedrooms 3
☐ Mobile Home No. Bathrooms 2
☐ Business No. Employees
☐ Other

Water Supply: ☐ Individual ☑ Public ☐ Community

Comments/Conditions: ① INSTALL 25% REDUCTION SYSTEM USING FIFTY (50) CHAMBERS OR THIRTY (30) HAS SECTIONS ② REPAIR SYSTEM CHANGED TO 50% REDUCTION TO ACCOMODATE, 36' WIDE HOUSE.

Comments/Conditions: ① SEPTIC TANK WITH MARKER INSTALLED USING "POLY LOK" FILTER ② TANKS AND DRAINFIELD INSPECTED & PRESSURE CHECKED 6-20-01

INITIAL SITE SKETCH

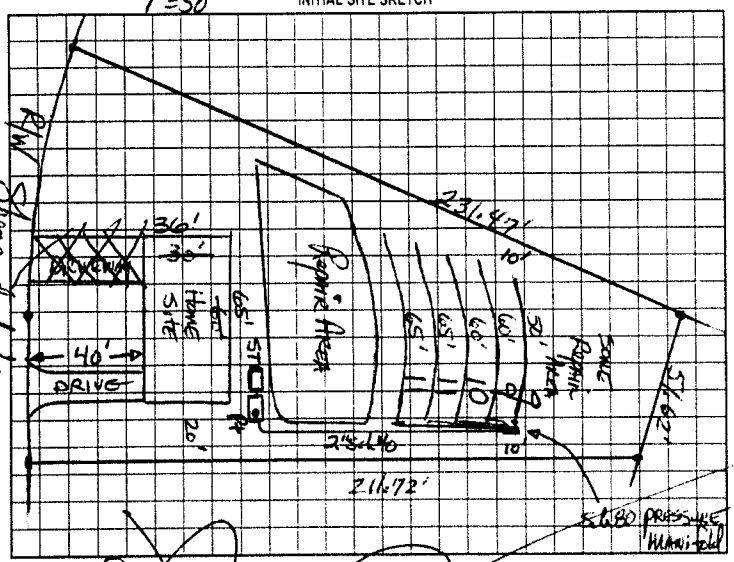

AS BUILT SKETCH

SYSTEM INSTALLED ACCORDING TO INITAL SITE SKETCH USING FIFTY (50) "INFILTRATOR" CHAMBERS

Permit can be suspended or revoked if any false information is supplied toward securing the permit/any unauthorized changes are made to the site/any unauthorized changes are made in the installation of the system. Improvement Permit with plat valid without expiration. Improvement Permit with site plan valid for sixty months. Authorization to Construct is valid for a period equal to that of Improvement Permit – not to exceed sixty months.

Signed: _____ date _____

Improvement Permit by: William O. Johnson RS date 1-17-01

Authorization to Construct by: STEVE HEARICK date 2-14-01

Installed by: ROWAN SEPTIC TANK

Operation Permit by: William O. Johnson date 8/24/01

Existing System Inspection by: _____ date _____

HEALTH DEPT COPY WHITE OWNER COPY (FINAL) YELLOW OWNER COPY (INITIAL) PINK