IREDELL COUNTY HEALTH DEPARTMENT

STATESVILLE 704-878-5305 MOORESVILLE 704-664-5281

IMPROVEMENT PERMIT / AUTHORIZATION TO CONSTRUCT / OPERATION PERMIT / EXISTING SYSTEM INSPECTION

PERMIT# 31675 PIN# 4730493437 (112) / 4730494487 (112) DATE 11-17-05

OWNER OR CONTRACTOR Carl Stamey PHONE: Business 704-528-1919 Home

ADDRESS 199 Waddell Road Mooresville NC 28115

LOCATION State Park Rd - meadow Glen - end Cul de sac

SUBDIVISION Meadow Glen BLOCK / SECTION LOT 111/112 LOT AREA SITE CLASS PS DESIGN FLOW 360 L.T.A.R. .3

Septic Tank: 1000 Gallons; STB 194 Date 2-15-05
Pump Tank: 1000 Gallons; PT 283 Date 10-21-05
Pump Make: Goulds Model WE0712H Serial No SD6253955
Nitrification Field: No Fields 1 Square Feet 200 Linear Feet 200
No Lines 5 Trench Width 36" Max Trench Bottom Depth 36" Gravel Depth NA

☑ New System ☐ Repair System Type: I, II, III, IV, V, VI
System Description: Pump 2550 PM
Repair System Description: LPP
Maintenance Agreement Required: ☐ Yes ☐ No None


☑ House/Mod. Home No. Bedrooms 3
☐ Mobile Home No. Bathrooms
☐ Business No. Employees
☐ Other
☐ Slab ☐ Crawl Space ☐ Basement w/plumbing ☐ Basement wo/plumbing

Water Supply: ☐ Individual ☑ Public ☐ Community


Comments:/Conditions: * see attached easement paperwork
Maintain all setbacks -
Install as Called

Comments:/Conditions: * Tanks must be maintained 50' away from stream
* Drain lines maintained 25' away from stormwater runoff -
- POLYLOK FILTER MARKER
- BUILDER SHOWED ME P/L & SYSTEMS IS 11' OFF P/L

INITIAL SITE SKETCH

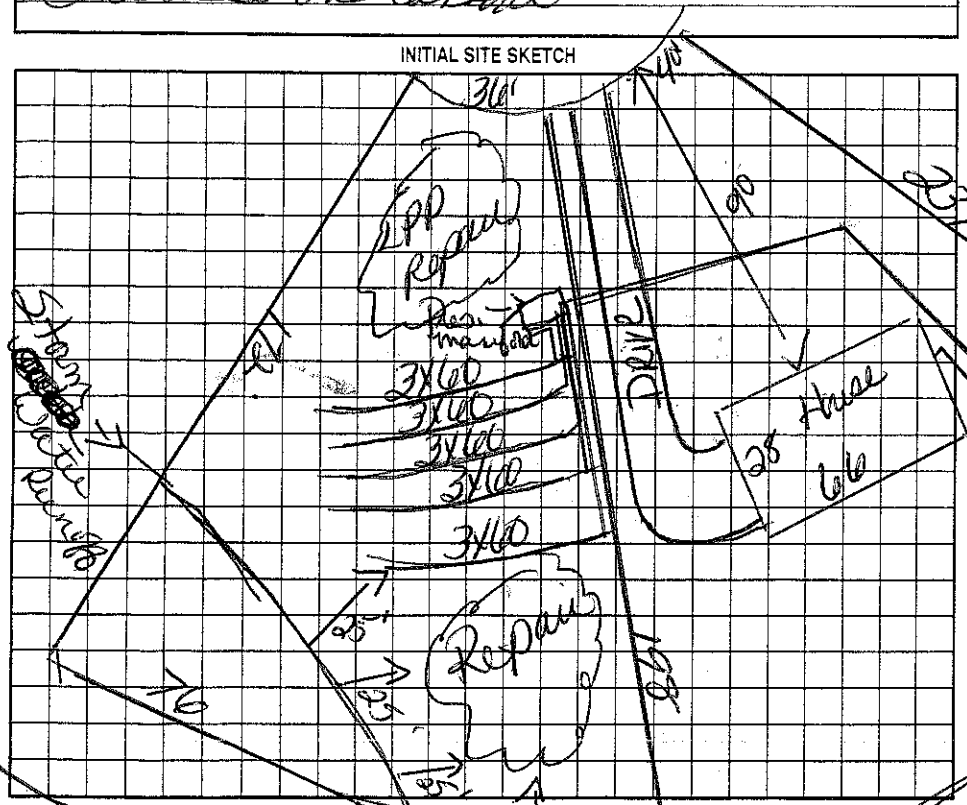

AS BUILT SKETCH

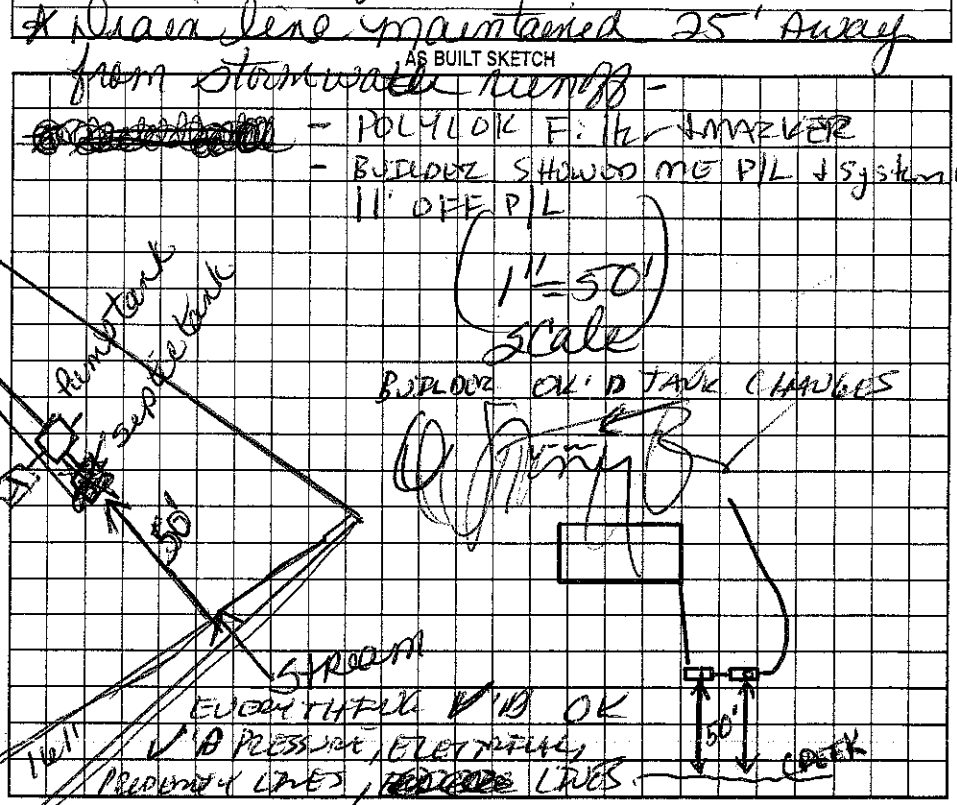

Permit can be suspended or revoked if any false information is supplied toward securing the permit/any unauthorized changes are made to the site/any unauthorized changes are made in the installation of the system. Improvement Permit with plat valid without expiration. Improvement Permit with site plan valid for sixty months. Authorization to Construct is valid for a period equal to that of Improvement Permit – not to exceed sixty months.

Signed: Jessie Hall date 11-17-05 Installed by: JST ENTERPRISES

Improvement Permit by: Kelly Cox date 11-17-05 Operation Permit by: [signature] date 12-8-05

Authorization to Construct by: Kelly Cox date 11-17-05 Existing System Inspection by: date

HEALTH DEPT. COPY: WHITE OWNER COPY (FINAL): YELLOW OWNER COPY (INITIAL): PINK