#105948

IREDELL COUNTY HEALTH DEPARTMENT

STATESVILLE 704-878-5305 300.00 Paid MOORESVILLE 704-664-5281

IMPROVEMENT PERMIT / AUTHORIZATION TO CONSTRUCT / OPERATION PERMIT / EXISTING SYSTEM INSPECTION

PERMIT# 21-2-0900 PIN# 4730-48-6343

OWNER OR CONTRACTOR C & S Associates PHONE: Business _____ Home _____ DATE July 3, 01

ADDRESS 4474 Lake Dr. Statesville Ford N.C. 28673

LOCATION State Park Rd. TR Meadow Glen Dr. on left past jct w/ Spring Lake Dr.

SUBDIVISION Meadow Glen BLOCK / SECTION 4 LOT 82 LOT AREA .34 Ac SITE CLASS PS DESIGN FLOW 360 gpd L.T.A.R. ~.3

Septic Tank: 1000 Gallons STB 825 Date 2-4-02
Pump Tank: _____ Gallons PT _____ Date _____
Pump Make: _____ Model _____ Serial No _____
Nitrification Field: No Fields 1 Square Feet 400/600 Linear Feet 200
No Lines 4 Trench Width 24" min 36" Max Trench Bottom Depth 32"

✓ New System ☐ Repair System Type: I II (III) IV V VI
System Description: Gravity PVC PS
Repair System Description: LP PVC PS
Maintenance Agreement Required: Yes ✓ No Initially
Gravel Depth N/A
Slab ✓ Crawl Space ☐ Basement w/plumbing ☐ Basement wo/plumbing

✓ House/Mod. Home No. Bedrooms 3
☐ Mobile Home No. Bathrooms 2
☐ Business No. Employees ____
☐ Other _____


Water Supply: ☐ Individual ✓ Public ☐ Community

Comments/Conditions: From Septic Tank, use (1) Flow Divider to (2) D-Boxes w/ Levelers/Equalizers - House Plans Attached 3/12/02
DO NOT cut around or lower House Site


Comments/Conditions: Pump to Trench Fields

1" = 50'

INITIAL SITE SKETCH

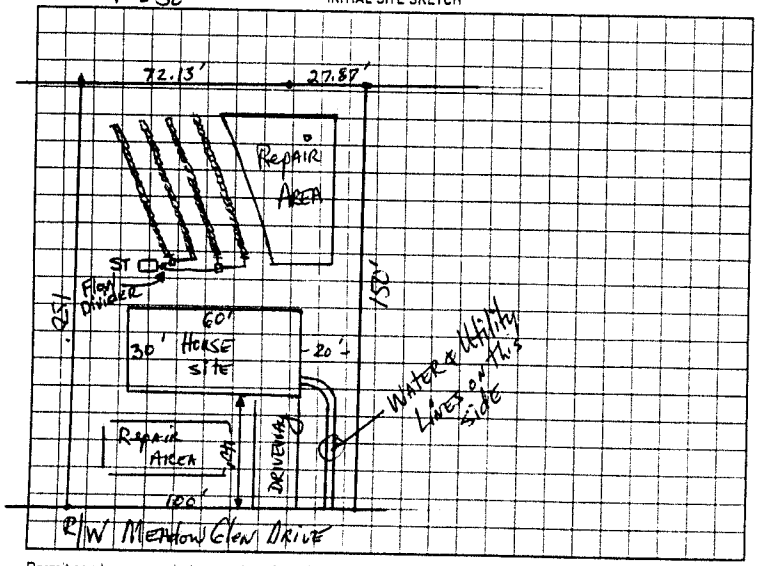

AS BUILT SKETCH

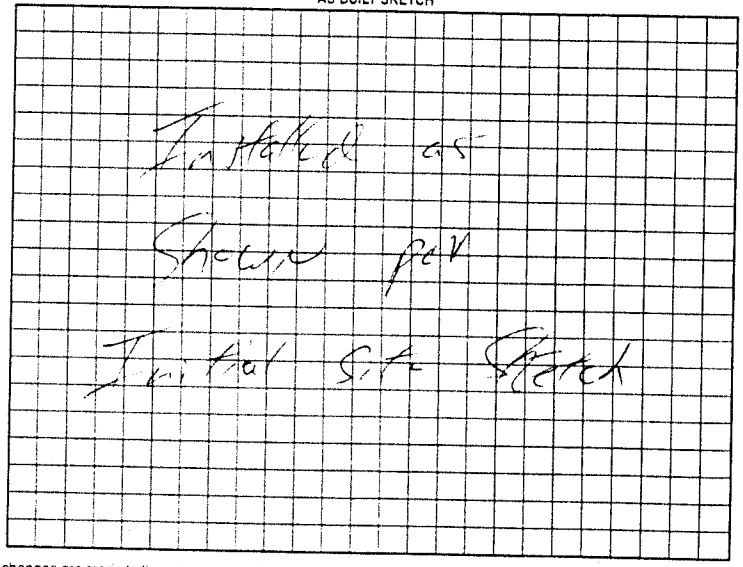

Permit can be suspended or revoked if any false information is supplied toward securing the permit; any unauthorized changes are made to the site any unauthorized changes are made in the installation of the system. Improvement Permit with plat valid without expiration. Improvement Permit with site plan valid for sixty months. Authorization to Construct is valid for a period equal to that of Improvement Permit – not to exceed sixty months.

Signed: La Verne Stanley date 7-16-01

Improvement Permit by: William E. Johnson RSI date 7-30-01

Authorization to Construct by: William E. Johnson RSI date 3-12-02

Installed by: Keever Septic

Operation Permit by: William E. Johnson date 6/11/02

Existing System Inspection by: _____ date _____

HEALTH DEPT. COPY WHITE OWNER COPY (FINAL) YELLOW OWNER COPY (INITIAL) PINK