92490

IREDELL COUNTY HEALTH DEPARTMENT

STATESVILLE 704-878-5305 — 4.00 MOORESVILLE 704-664-5281

IMPROVEMENT PERMIT / AUTHORIZATION TO CONSTRUCT / OPERATION PERMIT / EXISTING SYSTEM INSPECTION

PERMIT# Troutman - 05-7-0800 PIN# 4730-48-6343 DATE 9/20/00

OWNER OR CONTRACTOR DIXIELAND INC. PHONE: Business 202-4971 Home

ADDRESS 4474 LAKE DRIVE · SHERRILLS FORD - NC 28673

LOCATION PERTH RD - TR STATEPARK - TR MEADOW GLEN - ON CT NEAR END

SUBDIVISION MEADOW GLEN BLOCK / SECTION LOT 83 LOT AREA 1.356 AC SITE CLASS PS DESIGN FLOW 360GAD L.T.A.R. .30AD/FT2

Septic Tank: 1000 Gallons; STB 825 Date 10/9/00
Pump Tank: Gallons; PT Date
Pump Make: Model Serial No.
Nitrification Field: No Fields 1 Square Feet 400 Linear Feet 200
No Lines 5@40' Trench Width 24" Max Trench Bottom Depth 36" Gravel Depth N/A

☑ New System ☐ Repair System Type: I, II, III, IV, V, VI
System Description: GRAVITY PANEL
Repair System Description: PANEL / PUMP
Maintenance Agreement Required: ☐ Yes ☑ No


☑ House/Mod. Home No. Bedrooms 3
☐ Mobile Home No. Bathrooms 2
☐ Business No. Employees
☐ Other
☐ Slab ☑ Crawl Space ☐ Basement w/plumbing ☐ Basement wo/plumbing

Water Supply: ☐ Individual ☑ Public ☐ Community


Comments/Conditions:

Comments/Conditions: Poly Lok Fitter

INITIAL SITE SKETCH 1" = 50'

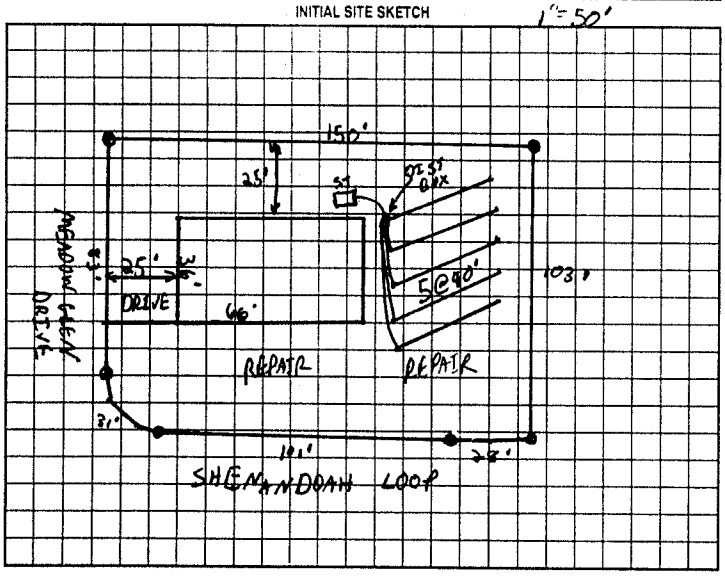

AS BUILT SKETCH

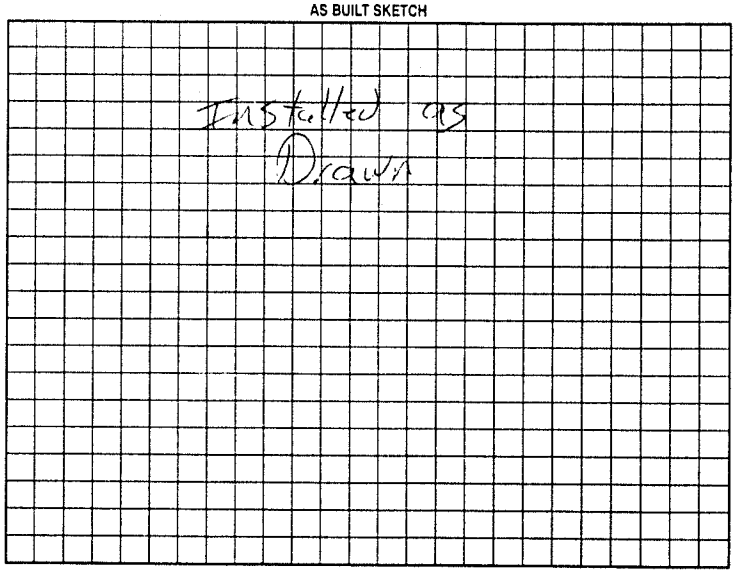

Permit can be suspended or revoked if any false information is supplied toward securing the permit/any unauthorized changes are made to the site/any unauthorized changes are made in the installation of the system. Improvement Permit with plat valid without expiration. Improvement Permit with site plan valid for sixty months. Authorization to Construct is valid for a period equal to that of Improvement Permit – not to exceed sixty months.

Signed: Regina Cecil date 9/25/00 Installed by: Rowan Septic

Improvement Permit by: C. Bly Tom RS date 9/20/00 Operation Permit by: RSJ date 12/12/00

Authorization to Construct by: C. Bly Tom RS date 9/20/00 Existing System Inspection by: date

HEALTH DEPT. COPY: WHITE OWNER COPY (FINAL): YELLOW OWNER COPY (INITIAL): PINK