IREDELL COUNTY HEALTH DEPARTMENT

STATESVILLE 704-878-5305 MOORESVILLE 704-664-5281

IMPROVEMENT PERMIT / AUTHORIZATION TO CONSTRUCT / OPERATION PERMIT / EXISTING SYSTEM INSPECTION

PERMIT# Townman/150591 PIN# 4730-79-6138 DATE 3-28-08

OWNER OR APPLICANT DPC Properties LLC PHONE: Business 704-998-8047 Home 704-662-3625

ADDRESS 9165 Fair Oak Drive Statesville NC 28677

LOCATION 215 (R) State Rd 1170 (Meadow Glen) 1st on Rt

SUBDIVISION Meadow Glen BLOCK / SECTION ____ LOT 114 LOT AREA .630 Ac SITE CLASS. R5 DESIGN FLOW 225 L.T.A.R. 1.3

Septic Tank: 1000 Gallons; STB 1000 Date 6-14-07

Pump Tank: 1000 Gallons; PT 307 Date 3-20-08

Pump Make: Zoeller Model N-152 Serial No. ____

Nitrification Field: No Fields ____ Square Feet 1,210 Linear Feet 210

No Lines 3 Trench Width 24" Max Trench Bottom Depth 36" Gravel Depth ____ ☐ Gravity ☑ Pressure

☑ New System ☐ Repair ☐ Expansion System Type: I II III (IV) V VI

System Description: 50% Low Pro

Repair System Description: 50% Low Pro

Maintenance Agreement Required: ☑ Yes ☐ No

☑ House/Mod. Home No. Bedrooms 3

☐ Mobile Home No. Persons ____

☐ Business No. Employees ____

☐ Other ____

Water Supply: ☐ Individual ☐ Public ☐ Community

☐ Slab ☐ Crawl Space ☑ Basement w/plumbing ☐ Basement wo/plumbing

Comments:/Conditions:

Comments:/Conditions:

Instal on Contour
Maintain all setbacks

INITIAL SITE SKETCH

(See Attached Drawing Dep Sept)

AS BUILT SKETCH


Permit can be suspended or revoked if any false information is supplied toward securing the permit/any unauthorized changes are made to the site/any unauthorized changes are made in the installation of the system. Improvement Permit with plat valid without expiration ☐ Improvement Permit with site plan valid for sixty months ☑ Authorization to Construct is valid for a period equal to that of Improvement Permit – not to exceed sixty months.

Signed: Danny Bowman date 3/28/08 Installed by: Bowman

Improvement Permit by: [signature] date 3-28-08 Operation Permit by: [signature] date 9-23-08

Authorization to Construct by: [signature] date 8-7-08 Existing System Inspection by: ____ date ____

HEALTH DEPT. COPY: WHITE OWNER COPY (FINAL): YELLOW OWNER COPY (INITIAL): PINK

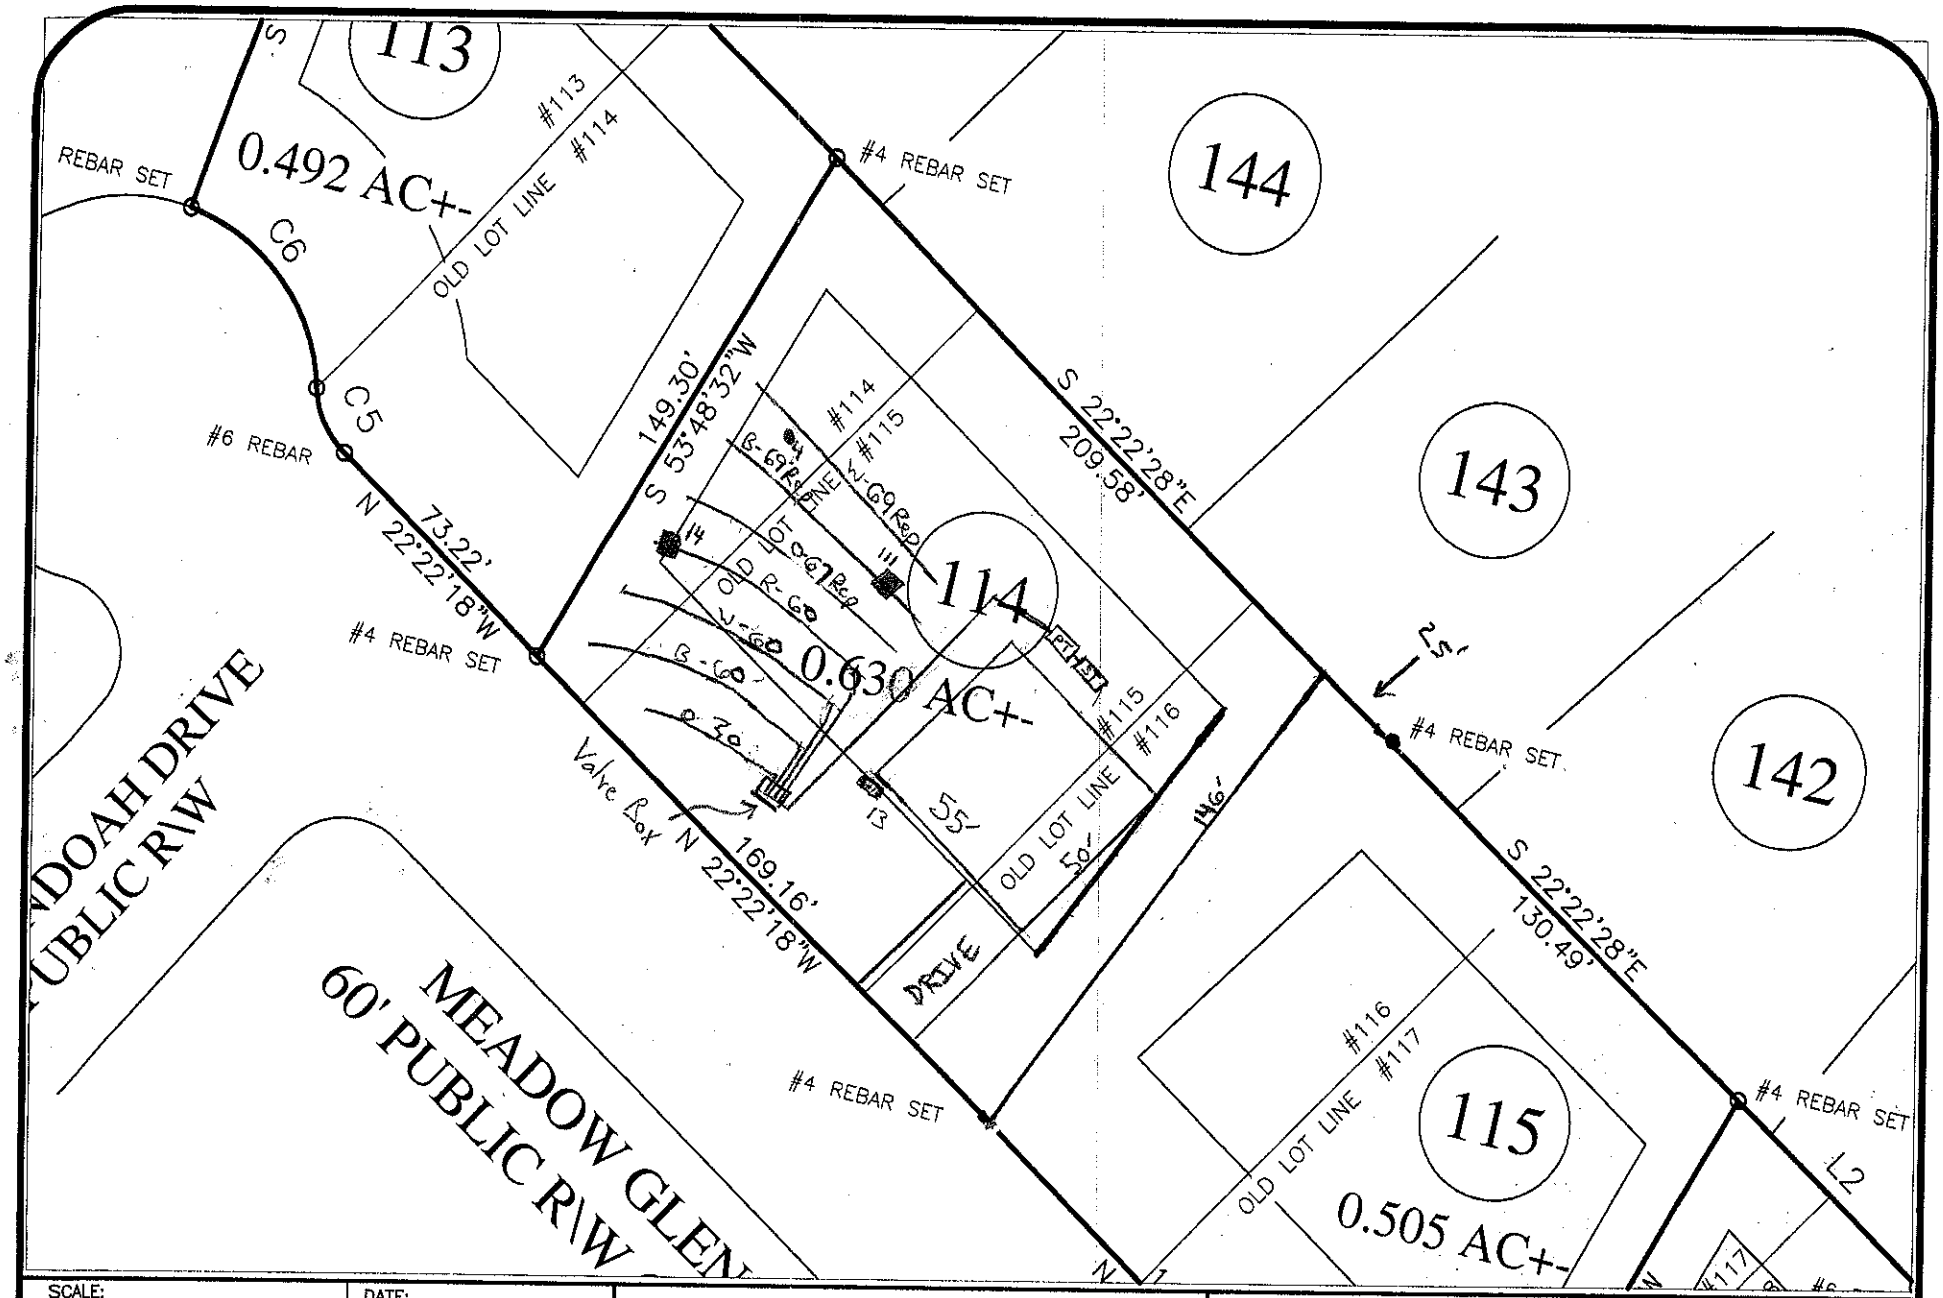

SCALE: 1" = 50'	DATE: 03/20/2008	S&ME 3718 OLD BATTLEGROUND ROAD GREENSBORO, NC 27410 PH. 336-288-7180 FAX. 336-288-8980 WWW.SMEINC.COM	Lot 114 Meadow Glen Subdivision Iredell County, NC	FIGURE NO. 1
PROJECT NO. 1588-08-015	DRAWN BY: PLM			
	CHECKED BY: PGP			