IREDELL COUNTY HEALTH DEPARTMENT

*THIS PERMIT VOIDS PREVIOUS PERMIT, ISSUED 09-12-01,

STATESVILLE 704-878-5305 MOORESVILLE 704-664-5281

IMPROVEMENT PERMIT / AUTHORIZATION TO CONSTRUCT / OPERATION PERMIT / EXISTING SYSTEM INSPECTION

PERMIT# TROUTMAN 114800 PIN# ~~4730-48-6343~~ 4730-49-7411 DATE 07/23/03

OWNER OR CONTRACTOR JANICE ESTES PHONE: Business 704-437-2580 ~~Home~~ 704-528-4941

ADDRESS 193 HEMLOCK RD. CLEVELAND, NC 27013

LOCATION STATE PARK RD., (R) MEADOW GLEN, (R) 1st Street, (L) SCOTCH IRISH, @ END ON CUL-DE-SAC

SUBDIVISION MEADOW GLEN BLOCK / SECTION IV LOT 145 LOT AREA 0.75 ACRES SITE CLASS. RS DESIGN FLOW 360 GPD L.T.A.R. 0.30 GPD/FT²

Septic Tank: 1,000 Gallons; STB 825 Date 11-07-03
Pump Tank: ____ Gallons; PT ____ Date ____
Pump Make: ____ Model ____ Serial No. ____
Nitrification Field: No Fields 1 Square Feet EQ to 1,200 Linear Feet 200
No Lines 4 @ 50' Trench Width 24" Max Trench Bottom Depth 36"

☒ New System ☐ Repair System Type: I, II, (III), IV, V, VI
System Description: 50% REDUCTION, GRAVITY
Repair System Description: 50% REDUC., LOW PRESS.
Maintenance Agreement Required: ☐ Yes ☒ No

☒ House/Mod. Home No. Bedrooms 3
☐ Mobile Home No. Bathrooms 2
☐ Business No. Employees ____
☐ Other


Water Supply: ☐ Individual ☒ Public ☐ Community

Gravel Depth N/A ☐ Slab ☒ Crawl Space ☐ Basement w/plumbing ☐ Basement wo/plumbing

Comments:/Conditions: (1) USE 11 PANELS PER LINE (44 PANELS TOTAL). (2) USE 1 FLOW DIVIDER "T" AND 2 DISTRIBUTION BOXES WITH SPEED LEVELERS TO achieve EQUAL DISTRIBUTION, P.L. 250'

Comments:/Conditions: (3) ONLY CHANGE FROM ORIGINAL PERMIT: HOME IS 45'X52' INSTEAD OF 40'X45'.

INITIAL SITE SKETCH

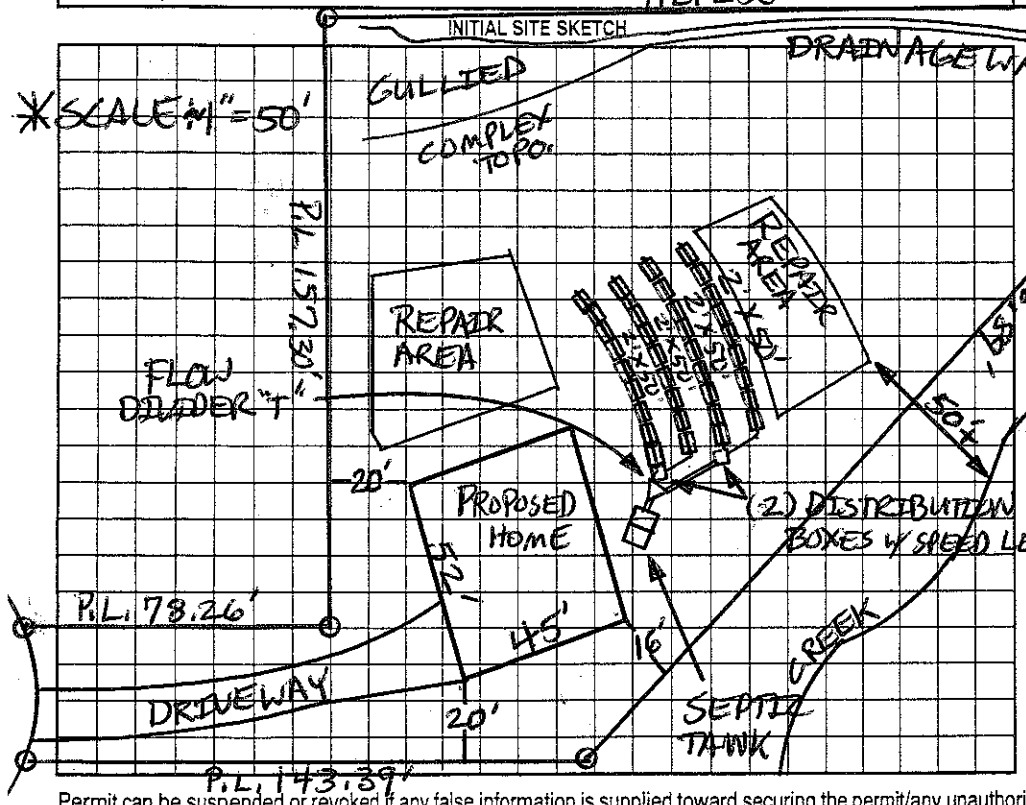

AS BUILT SKETCH

INSTALLED AS DRAWN
SEPTIC LINE & REPAIR IS EXACTLY 50' FROM CREEK

Permit can be suspended or revoked if any false information is supplied toward securing the permit/any unauthorized changes are made to the site/any unauthorized changes are made in the installation of the system. Improvement Permit with plat valid without expiration. Improvement Permit with site plan valid for sixty months. Authorization to Construct is valid for a period equal to that of Improvement Permit – not to exceed sixty months.

Signed: J Estes date 7-23-03 Installed by: ROWAN SEPTIC

Improvement Permit by: Patrick Mitchell date 07/23/03 Operation Permit by: [signature] RS date 12-30-03

Authorization to Construct by: Patrick Mitchell date 07/23/03 Existing System Inspection by: ____ date ____

HEALTH DEPT. COPY: WHITE OWNER COPY (FINAL): YELLOW OWNER COPY (INITIAL): PINK