IREDELL COUNTY HEALTH DEPARTMENT

STATESVILLE 704-878-5305 CI MOORESVILLE 704-664-5281

IMPROVEMENT PERMIT / AUTHORIZATION TO CONSTRUCT / OPERATION PERMIT / EXISTING SYSTEM INSPECTION

PERMIT# TROUTMAN (114781) PIN# 4730-48-6343 4730-49-8104 DATE 07/25/03

OWNER OR CONTRACTOR BURKE BUILDERS PHONE: Business 704-361-0047 Home 704-662-0047

ADDRESS P.O. BOX 3481 MOORESVILLE, NC 28117

LOCATION PERTH RD, (R) STATE PARK RD, (R) MEADOW GLEN DR. (R) 1ST RD. TO RIGHT, (L) SCOTCH IRISH LN., ON LEFT JUST BEFORE CUL-DE-SAC.

SUBDIVISION MEADOW GLEN BLOCK / SECTION 4 LOT 143 LOT AREA 0.44 ACRES SITE CLASS. PS DESIGN FLOW 360 GPD L.T.A.R. 0.30 GPD/FT²

Septic Tank: 1,000 Gallons; STB 786 Date 7-8-03
Pump Tank: 1,000 Gallons; PT 40 Date 7-8-03
Pump Make: Myers Model ME-100 Serial No. —
Nitrification Field: No Fields 1 Square Feet EQ to 1,200 Linear Feet 200
No Lines 5 @ 40' Trench Width 24" Max Trench Bottom Depth 36" Gravel Depth N/A

[X] New System [ ] Repair System Type: I, II, III, IV, V, VI
System Description: 50% REDUCTION, PUMP
Repair System Description: 50% REDUC., LOW PRESS.
Maintenance Agreement Required: [ ] Yes [X] No

[X] House/Mod. Home [ ] Mobile Home [ ] Business [ ] Other
No. Bedrooms 3 No. Bathrooms 2½ No. Employees —


[ ] Slab [X] Crawl Space [ ] Basement w/plumbing [ ] Basement wo/plumbing

Water Supply: [ ] Individual [X] Public [ ] Community


Comments/Conditions: (1) USE 9 PANELS PER LINE (45 PANELS TOTAL TO EQUAL 200'). (2) CALL PRIOR TO INSTALLATION FOR SYSTEM TO BE REFLAGGED &/OR PUMP & PRESSURE MANIFOLD) INFO.

Comments/Conditions: - Move S.T. to back right hand corner of house.
- poly lok Filter Installed
- lines okay 10/21/03
- Pressure check, Electrical & Alarm okay - 10/23/03

INITIAL SITE SKETCH

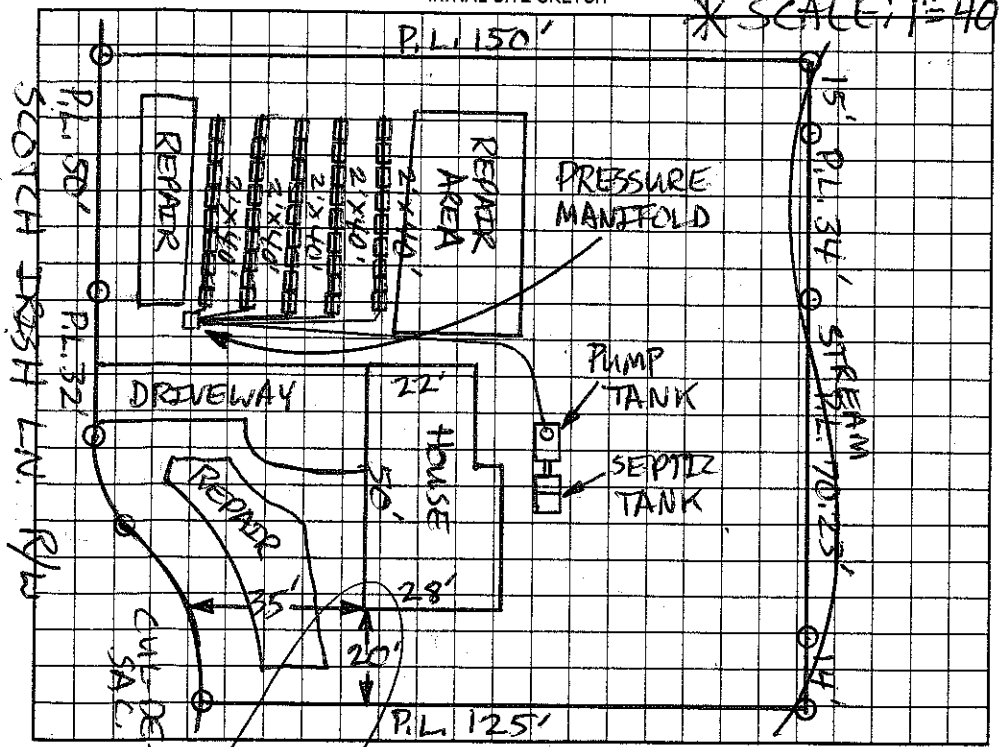

AS BUILT SKETCH

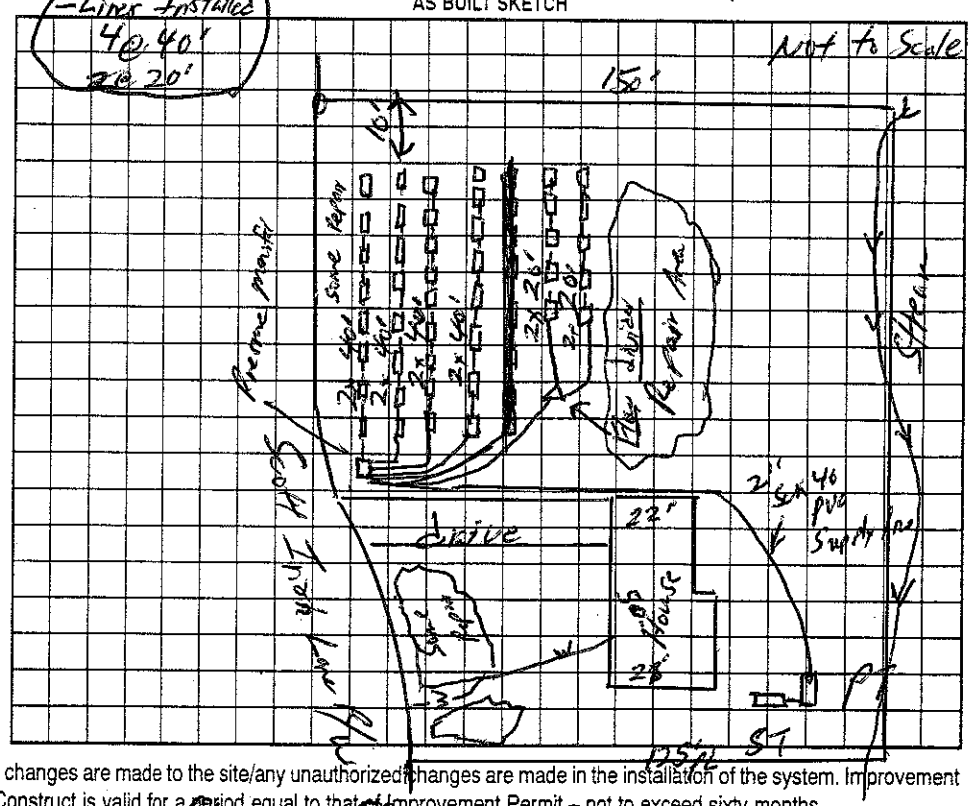

Permit can be suspended or revoked if any false information is supplied toward securing the permit/any unauthorized changes are made to the site/any unauthorized changes are made in the installation of the system. Improvement Permit with plat valid without expiration. Improvement Permit with site plan valid for sixty months. Authorization to Construct is valid for a period equal to that of Improvement Permit – not to exceed sixty months.

Signed: _____ date _____ Installed by: Phil Chepens

Improvement Permit by: Patrick Mitchell date 07/25/03 Operation Permit by: William G. John date 10/23/03

Authorization to Construct by: Patrick Mitchell date 07/25/03 Existing System Inspection by: _____ date _____

HEALTH DEPT. COPY: WHITE OWNER COPY (FINAL): YELLOW OWNER COPY (INITIAL): PINK