IREDELL COUNTY HEALTH DEPARTMENT

STATESVILLE 704-878- 525.00 Paid MOORESVILLE 704-664-

IMPROVEMENT PERMIT / AUTHORIZATION TO CONSTRUCT / OPERATION PERMIT / EXISTING SYSTEM INSPECTION

PERMIT# 126023 PIN# 4730508345 DATE 2-7-05

OWNER OR CONTRACTOR Jackie & Danny Shaw PHONE: Business 633-6188 Home

ADDRESS 6330 Mooresville Rd Salisbury NC 28147

LOCATION Perth Rd north TL Neil Farm Rd TR winding Shore 6th lot on left

SUBDIVISION C L & T BLOCK / SECTION 16 LOT 154 LOT AREA .166 Acres SITE CLASS. V RS DESIGN FLOW 480gpd L.T.A.R. .3

Septic Tank: 1000 Gallons; STB 760 Date 6-23-07
Pump Tank: 1000 Gallons; PT 363 Date 6-3-07
Pump Make: Zoeller Model N140-D Serial No.
Nitrification Field: No Fields 1 Square Feet 540 Linear Feet 270'
No Lines 6 Trench Width 24"-36" Max Trench Bottom Depth 30"-36" Gravel Depth N/A

☒ New System ☐ Repair System Type: I, II, III, IV, V, VI
System Description: Pump - LP - Panel Block
Repair System Description: * Lot recorded prior to 1983
Maintenance Agreement Required: ☐ Yes ☐ No


☒ House/Mod. Home No. Bedrooms 4
☐ Mobile Home No. Bathrooms
☐ Business No. Employees
☐ Other
☐ Slab ☐ Crawl Space ☐ Basement w/plumbing ☐ Basement wo/plumbing

Water Supply: ☒ Individual ☐ Public ☐ Community

Comments:/Conditions: Keep Septic, Septic at least 10' to PL, 50' to lake & 15' from cut 2FT or greater. Must be at least 50' from single family residence well.

Comments:/Conditions: * Lot deeded prior to 1983 – lot does not have 100% Repair area.
~~**~~ Must prove neighbor's well is only supplying one dwelling prior to issuance of AC

INITIAL SITE SKETCH Scale 1:50

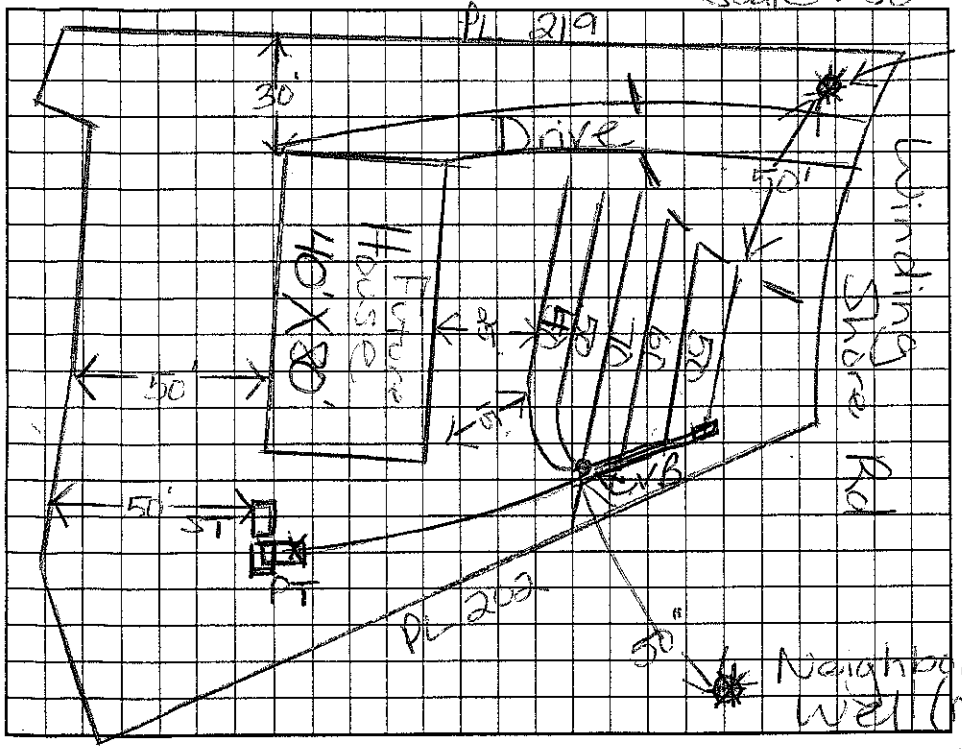

AS BUILT SKETCH

2/26/07 Reviewed Floor plan in compliance with original permit

7/11/07 Okay to move tanks to other side.
3/16" hole drilled

1/8/08 Checked lines
1/9/08 Checked pressure

Permit can be suspended or revoked if any false information is supplied toward securing the permit/any unauthorized changes are made to the site/any unauthorized changes are made in the installation of the system. Improvement Permit with plat valid without expiration. Improvement Permit with site plan valid for sixty months. Authorization to Construct is valid for a period equal to that of Improvement Permit – not to exceed sixty months.

Signed: Jackie Shaw date 2/8/05
Improvement Permit by: Maria H. Dotson RS date 2/7/05
Authorization to Construct by: Maria H. Dotson RS date 2/26/07

Installed by: Myers Septic RS
Operation Permit by: Maria H. Dotson date 1/15/08
Existing System Inspection by: date

HEALTH DEPT. COPY: WHITE OWNER COPY (FINAL): YELLOW OWNER COPY (INITIAL): PINK