IREDELL COUNTY HEALTH DEPARTMENT

STATESVILLE 704-878-5305 MOORESVILLE 704-664-5281

IMPROVEMENT PERMIT / AUTHORIZATION TO CONSTRUCT / OPERATION PERMIT / EXISTING SYSTEM INSPECTION

PERMIT# 135878 PIN# 4730-51-1078 4730-51-2083 DATE 5-23-06

OWNER OR CONTRACTOR ROBERT & JACQUELYN ELLIOTT PHONE: Business 704-746-5096 Home

ADDRESS C/O ASHLEY ROLLANS, 2120 GRAHAM ROAD, MT. ULLA NC 28125

LOCATION STATE PARK ROAD TO HONEYCUTT ROAD, DRIVEWAY STRAIGHT AHEAD AT RED FOX TRAIL INTERSECTION

SUBDIVISION LOUISE TROUTMAN BLOCK / SECTION LOT 6 LOT AREA 1.276 ACRES SITE CLASS. PS DESIGN FLOW 480 L.T.A.R. 0.25 GPD/FT²

Septic Tank: 1000 Gallons; STB 1007 Date 7-10-06

Pump Tank: 1000 Gallons; PT 374 Date 6-15-06

Pump Make: ZOELLER Model #153 Serial No.

Nitrification Field: No Fields 1 Square Feet 1920 Linear Feet 347

No Lines SEVEN Trench Width 24" Max Trench Bottom Depth 36" Gravel Depth SAND 24"

☑ New System ☐ Repair System Type: I, II, III, (IV), V, VI

System Description: 50% REDUCTION, LOW-PRESS,

Repair System Description: 50% REDUCTION, LOW-PRESS

Maintenance Agreement Required: ☑ Yes ☐ No

☑ House/Mod. Home No. Bedrooms 4

☐ Mobile Home No. Bathrooms

☐ Business No. Employees

☐ Other

☐ Slab ☐ Crawl Space ☑ Basement w/plumbing ☐ Basement wo/plumbing


Water Supply: ☑ Individual ☐ Public ☐ Community

WELL


Comments/Conditions: ① REMOVE EXISTING FIELD TERRACE ② REMOVE EXISTING CULVERTS & INSTALL NEW CULVERT DIVERTING WATER ACROSS DRIVEWAY AS SHOWN ③ INSTALL 80 PPBPS PANELS AS SHOWN.

Comments/Conditions: A CONTRACT SHALL BE EXECUTED BETWEEN THE SYSTEM OWNER & A MANAGEMENT ENTITY PRIOR TO ISSUANCE OF OPERATION PERMIT

INITIAL SITE SKETCH

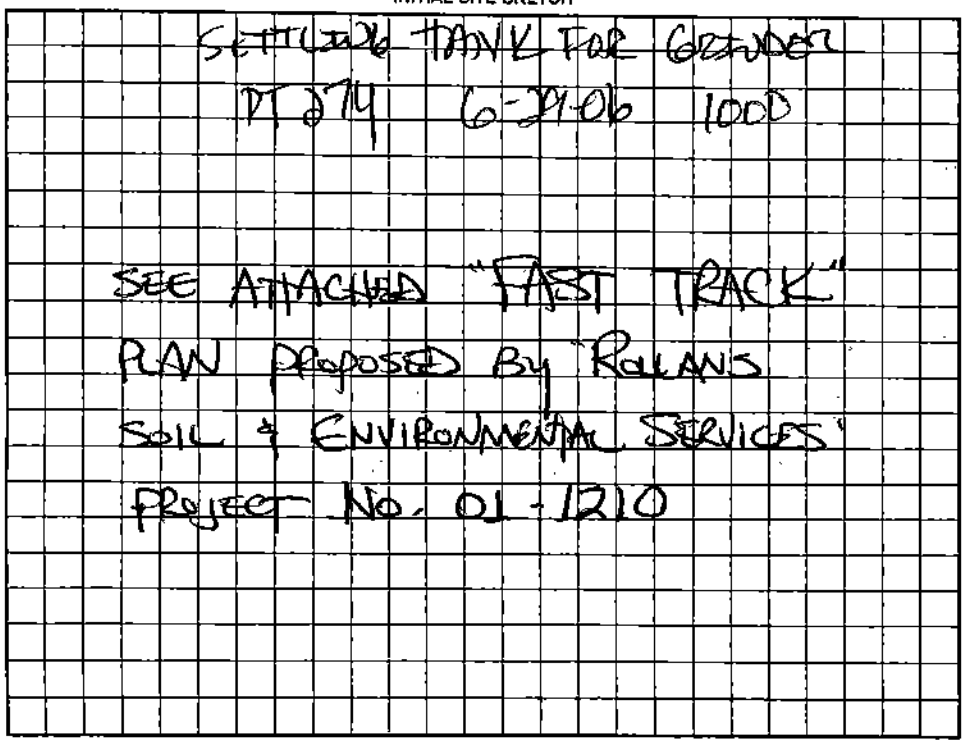

AS BUILT SKETCH

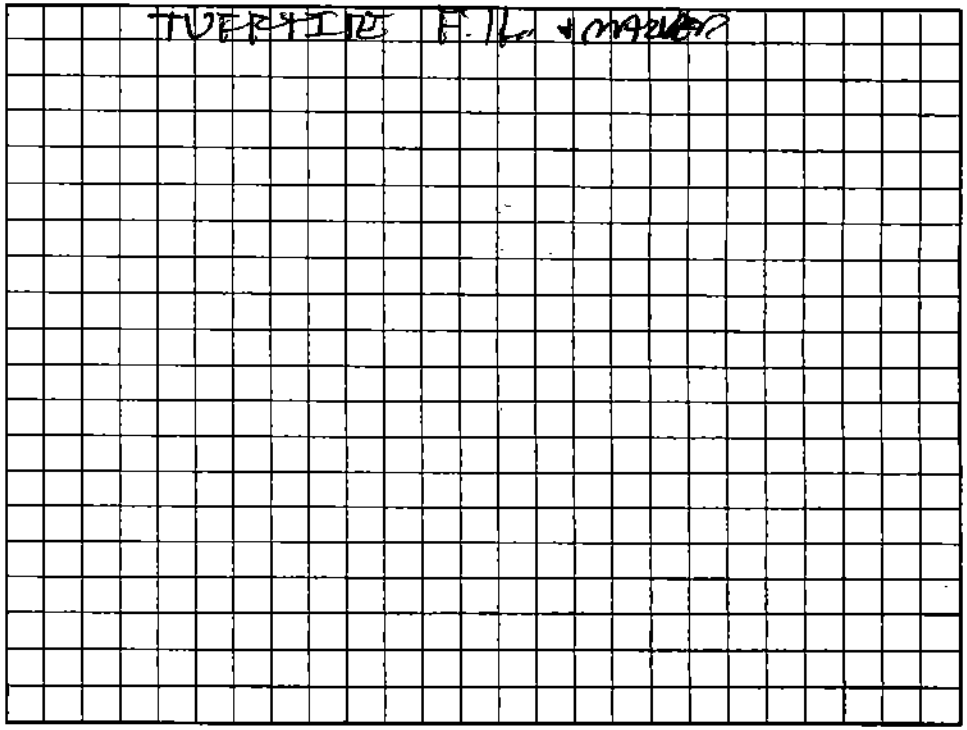

Permit can be suspended or revoked if any false information is supplied toward securing the permit/any unauthorized changes are made to the site/any unauthorized changes are made in the installation of the system. Improvement Permit with plat valid without expiration. Improvement Permit with site plan valid for sixty months. Authorization to Construct is valid for a period equal to that of Improvement Permit – not to exceed sixty months.

Signed: [signature] date 5/25/06 Installed by: TOMMY LOTHER

Improvement Permit by: STEVE HEDRICK date 5-23-06 Operation Permit by: [signature] date 8-25-06

Authorization to Construct by: STEVE HEDRICK date 5-23-06 Existing System Inspection by: date

HEALTH DEPT. COPY: WHITE OWNER COPY (FINAL): YELLOW OWNER COPY (INITIAL): PINK