IREDELL COUNTY HEALTH DEPARTMENT

STATESVILLE 704-878-5305 MOORESVILLE 704-664-5281

IMPROVEMENT PERMIT / AUTHORIZATION TO CONSTRUCT / OPERATION PERMIT / EXISTING SYSTEM INSPECTION

PERMIT# 73162 PIN# 4773051485 4 DATE 4-22-98

OWNER OR CONTRACTOR Preston H. Adams PHONE: Business Home 528 6425

ADDRESS 139 Skippers Cove Lane Troutman, N.C.

LOCATION Perth ch Rd TR State Pk Rd TL Honeycutt TL Tremont TR Skippers Cove on rt

SUBDIVISION Harlan Adams BLOCK / SECTION (Property) LOT 1 LOT AREA 1.6 acres SITE CLASS A DESIGN FLOW 360 L.T.A.R. .3

Septic Tank: 1000 Gallons; STB 1714 Date 5-17-95 ☐ New System ☐ Repair System Type: I, II, III, IV, V, VI

Pump Tank: Gallons; PT Date

Pump Make: Model Serial No.

System Description: Conv. Gravity

Repair System Description: Chambers

Maintenance Agreement Required: ☐ Yes ☐ No

Nitrification Field: No Fields 1 Square Feet 1200 Linear Feet 400

No Lines 3 Trench Width 36" Max Trench Bottom Depth 36" Gravel Depth 12"

☐ Slab ☐ Crawl Space ☐ Basement w/plumbing ☐ Basement wo/plumbing

☐ House/Mod. Home No. Bedrooms 3

☐ Mobile Home No. Bathrooms 2

☐ Business No. Employees

☐ Other


Water Supply: ☐ Individual ☐ Public ☐ Community

Comments:/Conditions:


Comments:/Conditions:

Existing P.L.

INITIAL SITE SKETCH

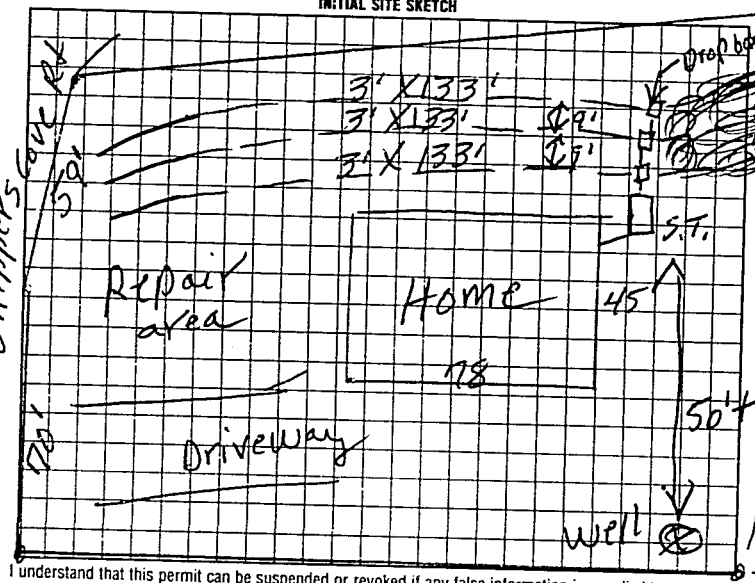

AS BUILT SKETCH

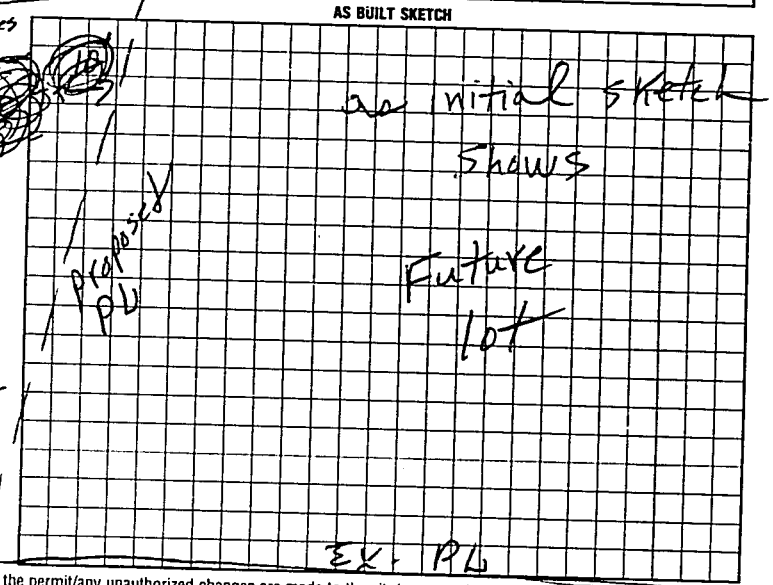

I understand that this permit can be suspended or revoked if any false information is supplied toward securing the permit/any unauthorized changes are made to the site/any unauthorized changes are made in the installation of the system. Improvement Permit with plat valid without expiration. Improvement Permit with site plan valid for sixty months. Authorization to Construct is valid for a period equal to that of Improvement Permit – not to exceed sixty months.

Signed: X [signature] date

Improvement Permit by: P. C. Moore date 4-22-98

Authorization to Construct by: P. C. Moore date 4-22-98

Installed by: James Hubler

Operation Permit by: P. C. Moore date 10-1-98

Existing System Inspection by: date

HEALTH DEPT. COPY WHITE INSPECTION COPY (FINAL) GREEN OWNER COPY (FINAL) YELLOW INSPECTION COPY (INITIAL) PINK