IREDELL COUNTY HEALTH DEPARTMENT

STATESVILLE 704-878-5305 MOORESVILLE 704-664-5281

IMPROVEMENT PERMIT / AUTHORIZATION TO CONSTRUCT / OPERATION PERMIT / EXISTING SYSTEM INSPECTION

DATE 5-10-07

PERMIT# 14D407 PIN# 4730518649 PHONE: Business _____ Home 704-896-8991

OWNER OR APPLICANT Rick & Mimi Sherman

ADDRESS 115 Viewlake St DAVIDSON, NC 28036

LOCATION State Park Rd, (E) Honeycutt (E) Tremont (E) Skipper's Cove (L) AT BOX # 137 OFF CD

SUBDIVISION _____ BLOCK / SECTION _____ LOT _____ LOT AREA 1.29 AC SITE CLASS PS DESIGN FLOW 240 L.T.A.R. EXISTING

EXISTING

Septic Tank: 1250 Gallons: STB _____ Date _____

Pump Tank: _____ Gallons: PT _____ Date _____

Pump Make: _____ Model _____ Serial No. _____

Nitrification Field: No Fields 1 Square Feet 321 Linear Feet 107'

No Lines _____ Trench Width 6'd 3' Max Trench Bottom Depth _____ Gravel Depth 30" ☒ Gravity ☐ Pressure

☐ New System ☐ Repair ☐ Expansion System Type: I (II) III IV V VI

System Description: EXISTING 6 GRAVEL/GRAVITY

Repair System Description: _____

Maintenance Agreement Required: ☐ Yes ☒ No

☒ House/Mod. Home ☐ Mobile Home ☐ Business ☐ Other _____

No. Bedrooms 2 No. Persons 4 No. Employees _____

Water Supply: ☒ Individual ☐ Public ☐ Community

☐ Slab ☒ Crawl Space ☐ Basement w/plumbing ☐ Basement wo/plumbing

Comments/Conditions: (1) THIS IS A PROPERLY FUNCTIONING SYSTEM IN USE WITH OLD PERMIT FOUND FOR 2 BEDROOMS, (2) BUILDER NEEDS TO DOUBLE CHECK SETBACKS BEFORE FOOTINGS ARE POD. (3) KEEP WELL

Comments/Conditions: 35' FROM HOME (4) MAINTAIN ALL SETBACKS

INITIAL SITE SKETCH

SEE ATTACHED SITE PLAN AND EXISTING SYSTEM SKETCH BY LORNE COOK, P.S.

AS BUILT SKETCH

Permit can be suspended or revoked if any false information is supplied toward securing the permit/any unauthorized changes are made to the site/any unauthorized changes are made in the installation of the system. Improvement Permit with plat valid without expiration. ☐ Improvement Permit with site plan valid for sixty months ☐ Authorization to Construct is valid for a period equal to that of Improvement Permit – not to exceed sixty months.

Signed: _____ date 5-1-07 Installed by: _____ date _____

Improvement Permit by: _____ date _____ Operation Permit by: _____ date 5-10-07

Authorization to Construct by: _____ date _____ Existing System Inspection by: _____ date _____

HEALTH DEPT. COPY: WHITE OWNER COPY (FINAL): YELLOW OWNER COPY (INITIAL): PINK

IREDELL COUNTY HEALTH DEPARTMENT

(SEPTIC TANK) IMPROVEMENTS PERMIT AND CERTIFICATE OF COMPLETION
(Ground Absorption Sewage Disposal System -- G. S. Chapter 130-Article 13C)

OWNER OR CONTRACTOR DAVID SMITH DATE 5-3-83 PERMIT NO. _____

PHONE: Business _____ Home _____

LOCATION State Park Rd. - off Perth Church Rd., T.L. on Honeycutt Rd. at house mtls. - T.L. on Tremont Rd., then T.R. at intersection - 100 yards on left R. N. _____

SUBDIVISION NAME _____ LOT NO. _____ SECTION OR BLOCK NO. _____

House ( ) Mobile Home ( ) Business ( ) Other Repair

No. Bedrooms 2 No. Bathrooms 1 Character & Porosity of Soil _____

Garbage Disposal Unit Yes ( ) No (✓) Percolation Rate _____


Auto. Dishwasher Yes (✓) No ( ) Topography Repair

Auto. Wash. Machine Yes (✓) No ( ) Depth to Water Table _____

Site Suitable Yes (✓) No ( ) Rock or other impervious formations _____

Lot Area Limited

_____ Basement with Plumbing _____ Basement without Plumbing ✓ No Basement

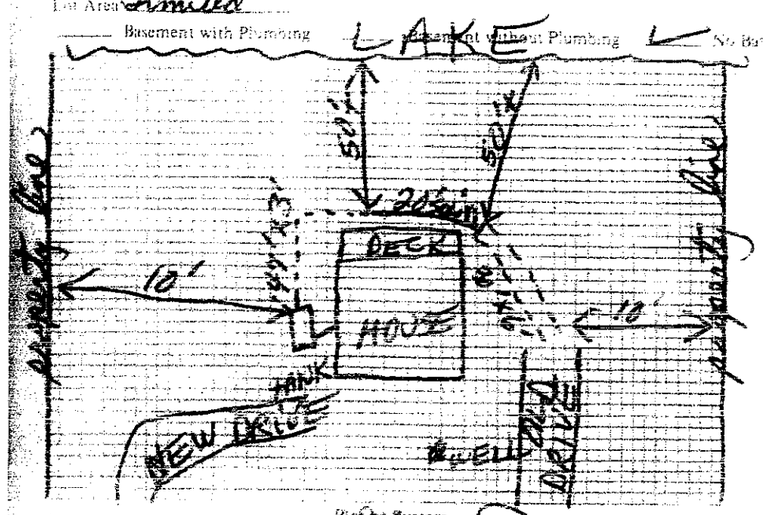

Size of Tank 1250 Gals.

Nitrification Field:
No. of Lines 3
Sq. Ft. 321 Linear Ft. 107

Depth of Stone in Lines 30"

Water Supply: Individual (✓)
Public ( )

Installed by J. C.'s Backhoe Ser.

I understand and agree to install septic tank system as specified on this Improvements Permit.

Signed: _____

Plot or System

IMPROVEMENTS PERMIT BY Steve Brown DATE _____

COMMENTS Repair - 1250 gal. tank installed. Landscape over drain lines for surface drainage. Pipe off downspouts from gutters as shown as below S.T. system with solid pipe.

CERTIFICATE OF COMPLETION BY Steve Brown DATE 5-3-83

EXISTING SYSTEM CHECKED BY: _____ DATE _____

CONSTRUCTION MUST COMPLY WITH ALL OTHER APPLICABLE STATE AND LOCAL REGULATIONS

Permit is VOID if any unauthorized changes are made in installation of system or if any false statement is supplied in securing Improvements Permit.

Health Dept. Copy - White Construction Dept. Copy - Yellow Sanitarian Copy - Pink

JAN. 4, 1989 1:57

DAS DON ALLEN & ASSOCIATES, P.A.

"Since 1971"

Commercial * Residential * Mortgage Surveys * Multi-Family
Construction Staking * Subdivision Design * Topographical
111-B Raceway Drive * Mooresville * NC * 28117
(704) 664-7029 (704) 664-8041 Fax


I, certify that this map was drawn under my supervision from an actual survey made under my supervision recorded in deed book 683, page 257, and/or plat book _____, page _____, that the ratio of precision is 1' 10,000, that this map was prepared in accordance with the General Statutes of North Carolina, Chapter 89C. my hand and seal on the 26, day of OCTOBER

PB 21 PG 33

WILLIAM M. ALLEN L-3499 PLS

Permit #140407

P.I.N. #4730518649

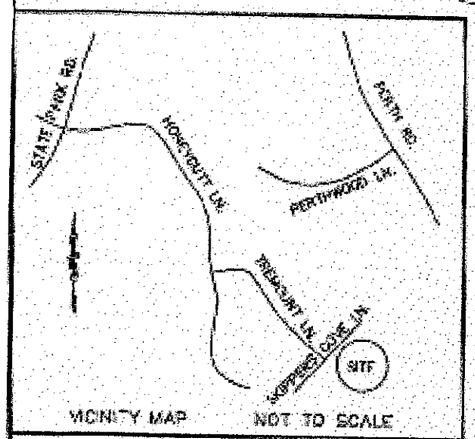

VICINITY MAP NOT TO SCALE

LAKE NORMAN

C.P.

I.P.S.

21.69'

S 53°05'29" W

50.31'

761' CONTOUR AS PER ACTUAL FIELD SURVEY

760' CONTOUR AS PER ACTUAL FIELD SURVEY

C.P.

I.P.S.

3'±45'

50'

20' SLOPE EASE

50'

35'

0.28 AC.

15' SLOPE EASE

30±6'

10'

CHAIN LINK FENCE (TYP)

159.34'

S 53°29'31" E

62'

18.7'

25'

EASEMENT

3/4" PIPE FOUND

3' GRAVEL

SHED

135.03'

N 53°29'52" W

130.03' TOT.

OLD HOME FOOT PRINT

NEW HOME FOOT PRINT

TRACT 3
RONALD E. TUTTLE
SHIRLEY A. TUTTLE
903/1831

TRACT 2
FBN DEVELOPMENT, INC.
1200/1533

LEGEND
- P.P. = POWER POLE
- S = SATELITE DISH
- C.P. = COMPUTED POINT
- I.P.S. = IRON PIN SET (#4 REBAR)
- R/W = RIGHT-OF-WAY
- W = WELL

GRAVEL DRIVE ENCROACHMENT

N 38°18'59" E 74.05'

#4 REBAR FOUND

158.41'

(BASE BEARING) S 53°53'32" E

15' EASEMENT PER MB 29 PG 30

PLASTIC FENCE (TYP)

(RE-ONLY) S 53°29'06" E 99.69'

#4 REBAR FOUND

3/4" PIPE FOUND

NOTES
1) THIS PROPERTY MAY BE SUBJECT TO ANY EASEMENT AND/OR RIGHTS-OF-WAY OF RECORD.
2) AREA COMPUTED BY THE COORDINATE METHOD.
3) EXISTING 760' & 761' CONTOUR ELEVATION BASED ON LAKE NORMAN LAKE LEVEL AT DOWAN'S FORD DAM (READING ON 757.0') ELEVATION: 10/24/2008
4) OVERHEAD POWER