IREDELL COUNTY HEALTH DEPARTMENT

STATESVILLE 704-878-5305 MOORESVILLE 704-664-5281 56322

IMPROVEMENT PERMIT / CERTIFICATE OF COMPLETION / OPERATION PERMIT / EXISTING SYSTEM INSPECTION

PROPERTY DESCRIPTION NO. 19382 DATE 9-28-94 TAX MAP NO. 3F-7-A-6 Watershed: ☐ Yes ☑ No

OWNER OR CONTRACTOR David B Peiton PHONE: Business Home 664-9583

ADDRESS 46 Trailing weed Lane. Mooresville, N.C. 28115

LOCATION From Troutman take Perth Rd TR State Park Rd TL Honeycutt Rd Th Tremont TR at end of cul-de-sac Lot on L

SUBDIVISION Tremont Sub. BLOCK / SECTION — LOT 6 LOT AREA .7 acre SITE CLASS. P.S. DESIGN FLOW 360 L.T.A.R. 3 gpd/ft²

Septic Tank: 1000 Gallons; STB 794 Date 9-11-95

Pump Tank: — Gallons; PT — Date —

Pump Make: — Model — Serial No. —

Nitrification Field: No Fields 1 Square Feet 1200 Linear Feet 400'

No Lines 6 Trench Width 36" Max Trench Bottom Depth 24"

☑ New System ☐ Repair System Type: I, II, III, IV, V, VI

System Description: Conventional, gravity fed

Repair System Description: pump to conventional

Maintenance Agreement Required: ☐ Yes ☑ No

Gravel Depth 12"

☑ House/Mod. Home No. Bedrooms 3

☐ Mobile Home No. Bathrooms 2-5

☐ Business No. Employees

☐ Other


☐ Slab ☐ Crawl Space ☑ Basement w/plumbing ☐ Basement wo/plumbing

Water Supply: ☑ Individual ☐ Community ☐ Public


Comments: INSTALL SYSTEM SHALLOW (no deeper than 24" to trench bottom) Keep lines and trenches on contour. Keep system min 5' from foundation of home, 10' from all property lines, 50' min from any well, and 5' from 760' elevation. 100% Repair at top of lot, pump to conventional. * No cutting or filling in or around area where septic system is to be installed.

Comments:

INITIAL SITE SKETCH

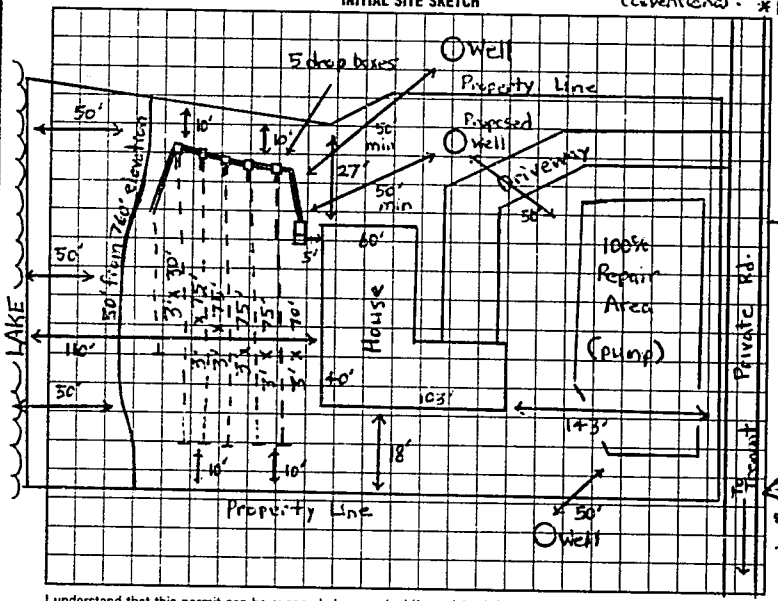

AS BUILT SKETCH

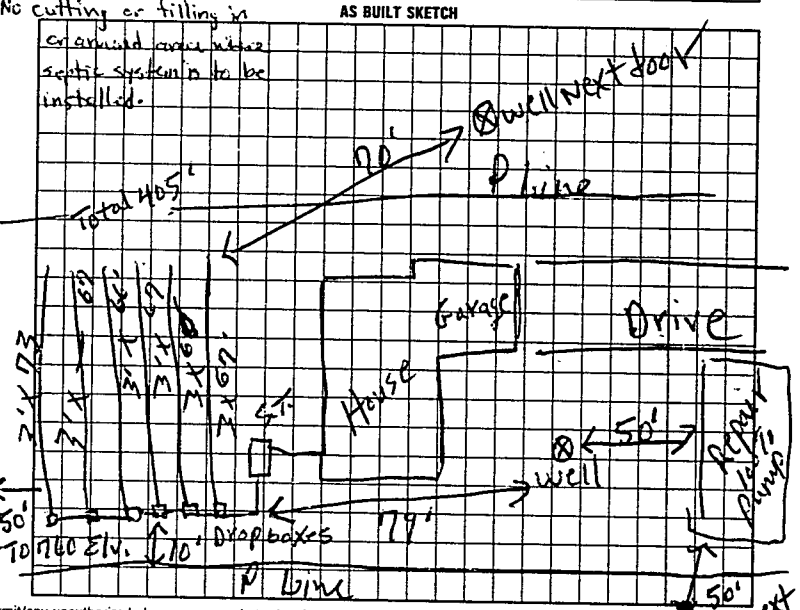

I understand that this permit can be suspended or revoked if any false information is supplied toward securing the permit/any unauthorized changes are made to the site/any unauthorized changes are made in the installation of the system. Improvement Permit is valid for 60 months from date of issuance.

Signed: D a B

Improvement Permit by: Michael J. Dennis date 9-30-94

Existing System Inspection by: date

Installed by: F. J. Ervin

Certificate of Completion by: date

Operation Permit by: J. C. Moore date 11-9-95

HEALTH DEPT. COPY: WHITE INSPECTION COPY (FINAL): GREEN OWNER COPY (FINAL): YELLOW INSPECTION COPY (INITIAL): PINK OWNER COPY (INITIAL): GOLD

E 1 5 1 0 0