IREDELL COUNTY HEALTH DEPARTMENT

STATESVILLE 704-878-5305 MOORESVILLE 704-664-5281

IMPROVEMENT PERMIT / AUTHORIZATION TO CONSTRUCT / OPERATION PERMIT / EXISTING SYSTEM INSPECTION

PERMIT# 069388 PIN# 4730522803

OWNER OR CONTRACTOR Tim & Sherry Johnson DATE July 24, 00

ADDRESS 2134 Twilight Rd Mooresville PHONE: Business 309-5082, 873-9831 Home

LOCATION State Park Road TL Honeycutt TL Tremont on left

SUBDIVISION Tremont BLOCK / SECTION LOT 19 LOT AREA 1.51AC SITE CLASS PS DESIGN FLOW 360gpd L.T.A.R. .33 ±

Septic Tank: 1000 Gallons; STB 312 Date 6-24-00
Pump Tank: Gallons; PT Date
Pump Make: Model Serial No.
Nitrification Field: No Fields Square Feet N/A ± Linear Feet 360 ±
No Lines 4 @ 90'± Trench Width 36" Max Trench Bottom Depth 36"

☑ New System ☐ Repair System Type: I, II, III, IV, V, VI
System Description: Gravity Conventional
Repair System Description: Grav/pumped conventional
Maintenance Agreement Required: ☐ Yes ☑ No
Gravel Depth 12" ☐ Slab ☑ Crawl Space ☐ Basement w/plumbing ☐ Basement wo/plumbing


☑ House/Mod. Home No. Bedrooms 3
☐ Mobile Home No. Bathrooms 2
☐ Business No. Employees
☐ Other

Water Supply: ☑ Individual ☐ Public ☐ Community


Comments/Conditions:

Comments /Conditions

INITIAL SITE SKETCH

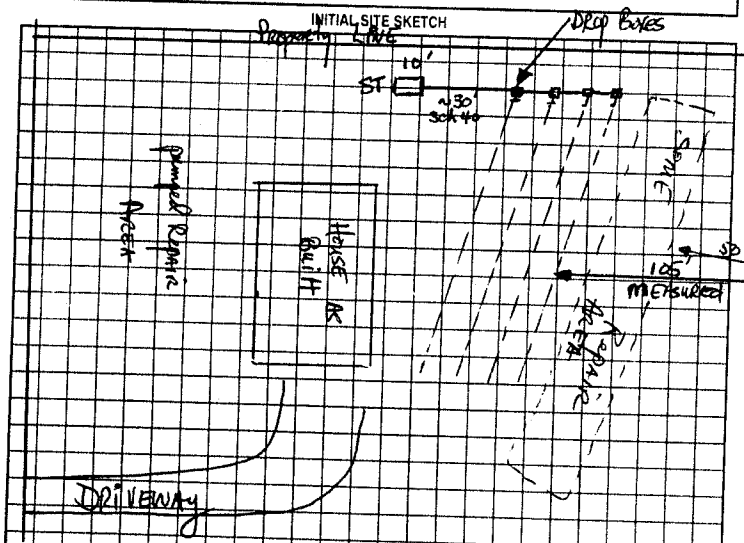

AS BUILT SKETCH

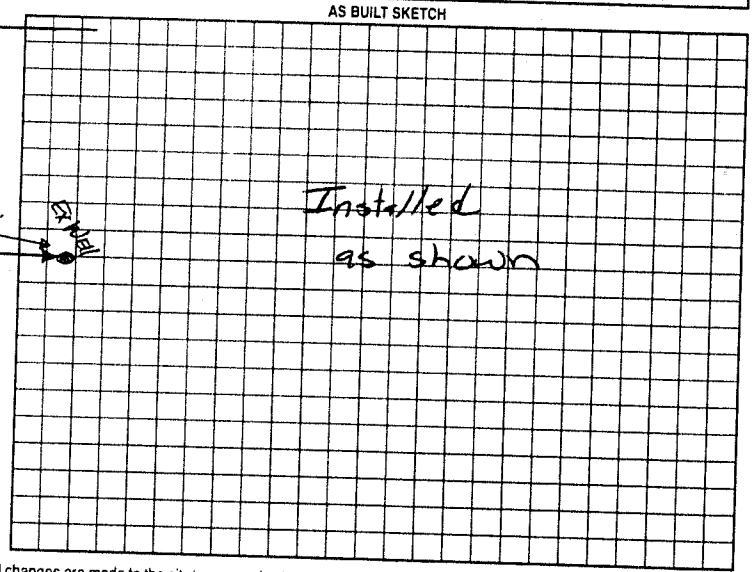

Permit can be suspended or revoked if any false information is supplied toward securing the permit/any unauthorized changes are made to the site/any unauthorized changes are made in the installation of the system. Improvement Permit with plat valid without expiration. Improvement Permit with site plan valid for sixty months. Authorization to Construct is valid for a period equal to that of Improvement Permit – not to exceed sixty months.

Signed: date

Improvement Permit by: RS date 7-24-00

Authorization to Construct by: RS date 7-24-00

Installed by: Wayne Orbison

Operation Permit by: Mary Craft RS date 8-1-00

Existing System Inspection by: date

HEALTH DEPT. COPY: WHITE OWNER COPY (FINAL): YELLOW OWNER COPY (INITIAL): PINK