paid $125.00 @ Building Inspections per Lafonda

IREDELL COUNTY HEALTH DEPARTMENT

STATESVILLE 704-878-5305 MOORESVILLE 704-664-5281

IMPROVEMENT PERMIT / AUTHORIZATION TO CONSTRUCT / OPERATION PERMIT / EXISTING SYSTEM INSPECTION

PERMIT# 88889 PIN# 4730 52 4084 DATE Apr 12-2000

OWNER OR CONTRACTOR CHRIS STROM OWNER MARK & JOAN CHAMP PHONE: Business _____ Home _____

ADDRESS 244 168 Tremont Ln Troutman NC

LOCATION Hwy 21 5th (R) Rath (R) State Park (L) Honeycutt (Before Lockhart) (L) Tremont Sixth on Right AT Intersection of Stepcase Cove

SUBDIVISION Tremont BLOCK / SECTION _____ LOT 8 LOT AREA _____ SITE CLASS. _____ DESIGN FLOW 480 L.T.A.R. .4/per MH's Room

Septic Tank: 1250 Existing Gallons: STB _____ Date _____

Pump Tank: _____ Gallons: PT _____ Date _____

Pump Make: _____ Model _____ Serial No. _____

Nitrification Field: No Fields 1 Square Feet 1200 sq ft Linear Feet 400 Total

No Lines 4 Trench Width 36" Max Trench Bottom Depth 36-40" Gravel Depth 14" ±

☑ New System ☐ Repair System Type: ☐ I ☐ II ☐ III ☐ IV ☐ V ☐ VI

System Description: Conv. Gravity

Repair System Description: Same Reduction Possible

Maintenance Agreement Required: ☐ Yes ☑ No

☑ House/Mod. Home No. Bedrooms 4

☐ Mobile Home No. Bathrooms 3

☐ Business No. Employees _____

☐ Other _____

☐ Slab ☐ Crawl Space ☑ Basement w/plumbing ☐ Basement wo/plumbing


Water Supply: ☑ Individual ☐ Public ☐ Community WELL


Comments/Conditions: Orginal Permit Mary Pike 6-19-91

1. Recommend pumping Septic Tank And inspecting outlet Tee Replace if needed.
2. Replace Distribution Box w/ Speed Levels Feed New Line 1st Top Two Next 3rd Line INITIAL SKETCH Call 922 2030 if Questions

Comments/Conditions: New D Box Sex w/ Speed Levels

AS BUILT SKETCH

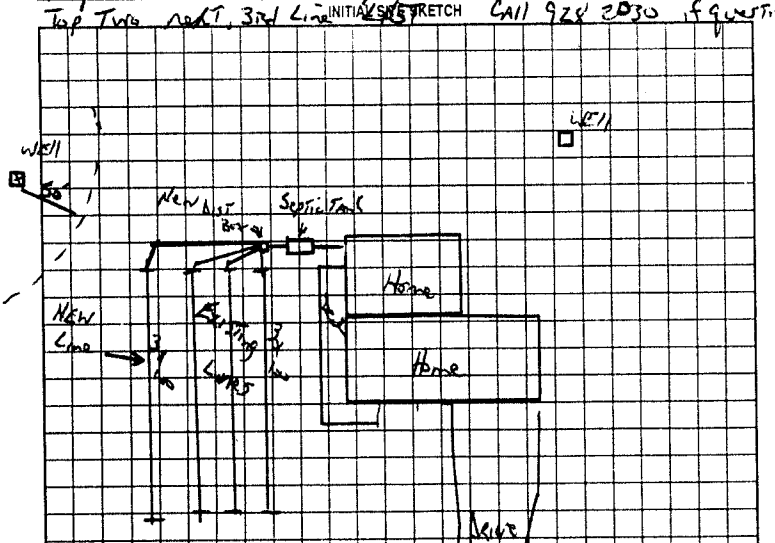

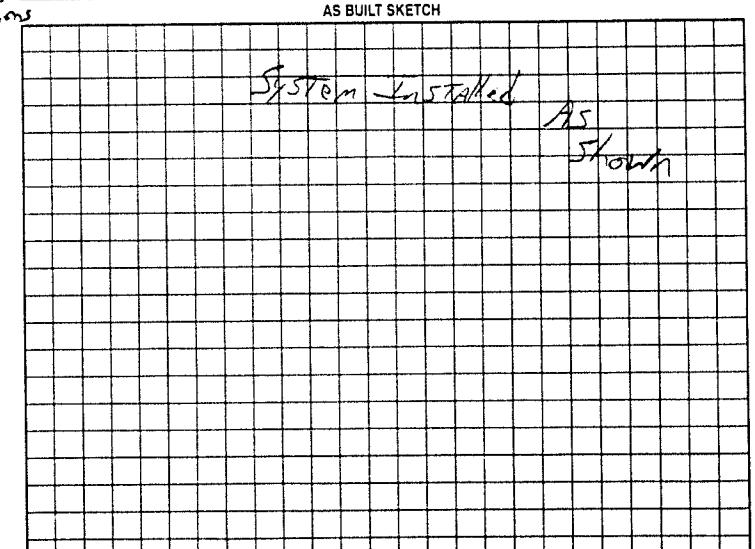

Permit can be suspended or revoked if any false information is supplied toward securing the permit/any unauthorized changes are made to the site/any unauthorized changes are made in the installation of the system. Improvement Permit with plat valid without expiration. Improvement Permit with site plan valid for sixty months. Authorization to Construct is valid for a period equal to that of Improvement Permit – not to exceed sixty months.

Signed: _____ date Apr 13/2000 Installed by: J + J Backhoe

Improvement Permit by: J.C. Potter date Apr 12 2000 Operation Permit by: J.C. Potter date June 8-2000

Authorization to Construct by: J.C. Potter date Apr 12 2000 Existing System Inspection by: _____ date _____

HEALTH DEPT COPY WHITE OWNER COPY (FINAL) YELLOW OWNER COPY (INITIAL) PINK