IREDELL COUNTY HEALTH DEPARTMENT

Statesville Office (704) 878-5305 Mooresville Office (704) 660-3625 PERMIT # 1030 215567

IMPROVEMENT PERMIT / AUTHORIZATION TO CONSTRUCT / OPERATION PERMIT / EXISTING SYSTEM

PIN # 4730531516.191

APPLICANT: Jasper Builders Inc APPLICANT ADDRESS: 181 W. Statesville Ave Mooresville NC

SITE ADDRESS: 191 Honeycutt Rd Troutman NC 28166 PHONE: 704-799-9982 ALT. PHONE: 704-201-4980

SITE DIRECTIONS: 215 T/R Perth Rd T/R State Park Rd T/L Honeycutt Rd Lot on left


SUBDIVISION: N/A SECTION: N/A LOT # N/A LOT AREA: 24.631ac DESIGN FLOW: 100 L.T.A.R.: 0.25

Septic Tank	1000 (gal)	STB	744	Date	7/28/16	☒ New System	☐ Repair	☐ Expansion	System Type: I II ☒ III IV V VI	☐ Residence	No. Bedrooms 1
Pump Tank	(gal)	PT		Date		System Description:	25% Reduction			☐ Business	No. Persons Bathroom
Pump Make		Model		Serial #		Repair System Description:	25% Reduction			☒ Other	No. Employees
# Nitrification Fields	1	# Lines	1	Linear Ft:	100	Maintenance Agreement Required:	☐ YES	☑ NO		☐ Slab	☐ Crawl Space
Trench Width	36"	Max. Trench Bottom Depth	36"	Gravel Depth	N/A		☑ GRAVITY	☐ PRESSURE		☒ Basement w/ plumbing	☐ Basement w/o plumbing


Water Supply: ☒ Private ☐ Public ☐ Community

Comments / Conditions: Install 25% Reduction on contour with serial distribution. Install trench @ 36" on high side.

INITIAL SITE SKETCH

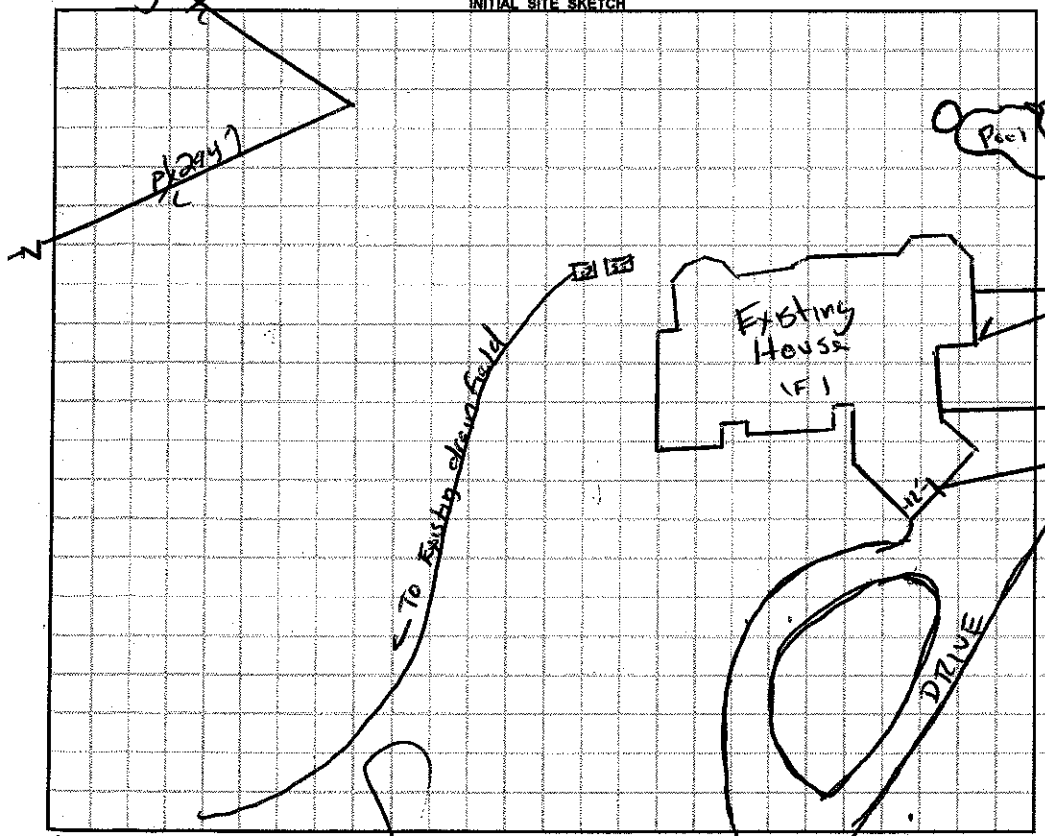

AS BUILT SKETCH

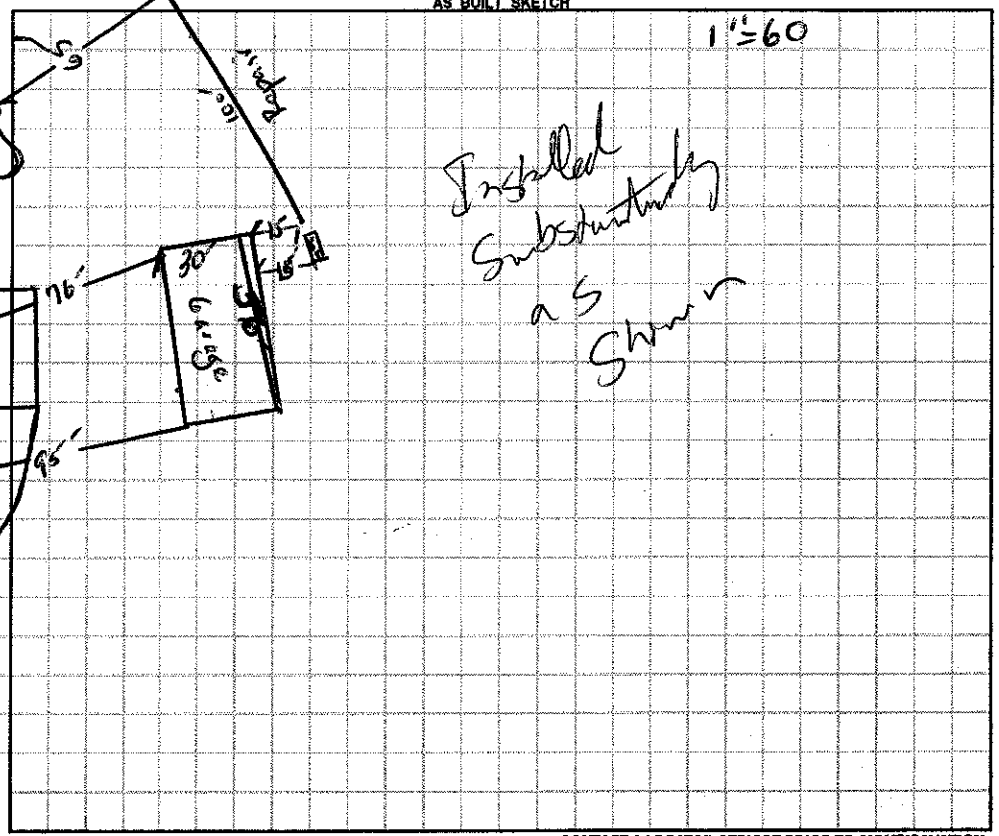

Permit can be suspended or revoked if any false information is supplied toward securing the permit / any unauthorized changes are made to the site / any unauthorized changes are made in the installation of the system. **CONTACT A LOCATOR SERVICE PRIOR TO ANY EXCAVATION**

☐ **IMPROVEMENT PERMIT** *with plat valid without expiration.* ☒ **IMPROVEMENT PERMIT** *with site plan valid for 60 mos.* ☑ **AUTHORIZATION TO CONSTRUCT** *valid for period equal to IMPROVEMENT PERMIT--not to exceed 60 mo.*

Owner / Applicant Signature: Date: 1/11/16 Installed by: Abernathy

IMPROVEMENT PERMIT by: Date: 01/11/16 OPERATION PERMIT by: Date: 8/9/16

AUTHORIZATION TO CONSTRUCT by: Date: 01/11/16 Existing System Inspected by: Date:

Health Dept. Copy - WHITE Applicant (Final Approval) - YELLOW Applicant (Conditional Approval) - PINK