IREDELL COUNTY HEALTH DEPARTMENT

STATESVILLE 704-878-5305 MOORESVILLE 704-664-5281

IMPROVEMENT PERMIT / AUTHORIZATION TO CONSTRUCT / OPERATION PERMIT / EXISTING SYSTEM INSPECTION

PERMIT# 11504G PIN# 4930-53-1516.B DATE 8/29/03

OWNER OR CONTRACTOR Gary Wood Construction PHONE: Business (704) 634-3751 Home —

ADDRESS 600 Union West Blvd Matthews, N.C. 28104

LOCATION Perth Road, (R) to State Park Road, (L) on Honeycutt Rd., ~.3 mile on Left (191 Honeycutt) about 1 mile off road.

SUBDIVISION — BLOCK / SECTION — LOT — LOT AREA 24.889 Ac SITE CLASS. 75 DESIGN FLOW 600 L.T.A.R. .30 gpd/ft²

Septic Tank: 1,500 Gallons; STB 338 Date 5-28-04

Pump Tank: 1,500 Gallons; PT ~~339~~ 353 Date 1-5

Pump Make: Myers Model M505-11 Serial No. —

Nitrification Field: No Fields 1 Square Feet 2,000 Linear Feet 670

No Lines 5@134 Trench Width 36" Max Trench Bottom Depth 30" Gravel Depth 12"

☒ New System ☐ Repair System Type: I, II, (III) IV, V, VI

System Description: Pump, Conventional

Repair System Description: Pump, Conventional

Maintenance Agreement Required: ☐ Yes ☒ No

☒ House/Mod. Home No. Bedrooms 5

☐ Mobile Home No. Bathrooms 6

☐ Business No. Employees —

☐ Other —


☐ Slab ☐ Crawl Space ☒ Basement w/plumbing ☐ Basement wo/plumbing

Water Supply: ☒ Individual ☐ Public ☐ Community


Comments/Conditions: (1) Install Lines on Contour @ keep well 100 Ft from Septic System (3) maintain proper setbacks (4) See Attachments "A" & "B" for pump information

Comments/Conditions: Zabel Filter, ST Risers Installed; Lines checked okay 7/14/04; Pressure check okay 8/3/04; Electrical + Alarm okay 8/4/04

INITIAL SITE SKETCH

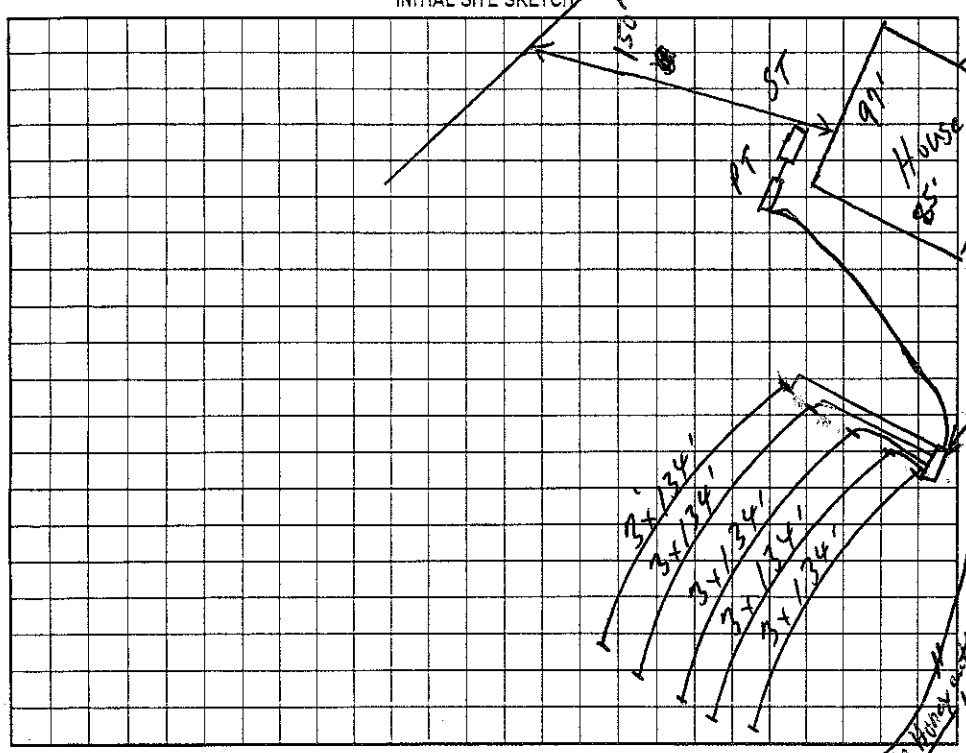

AS BUILT SKETCH

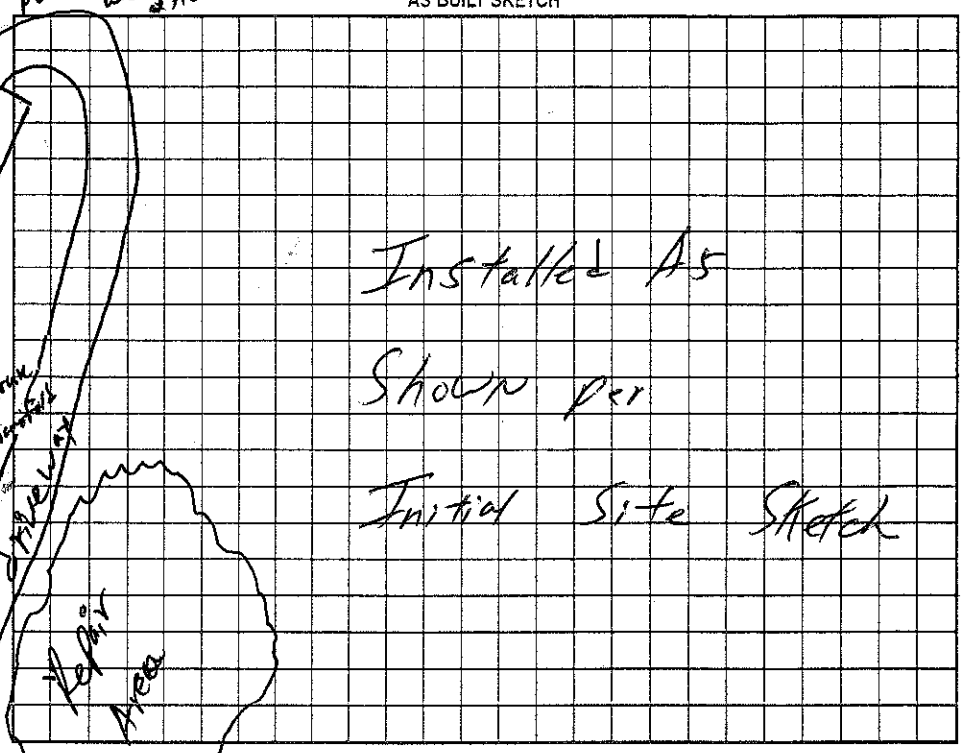

Permit can be suspended or revoked if any false information is supplied toward securing the permit/any unauthorized changes are made to the site/any unauthorized changes are made in the installation of the system. Improvement Permit with plat valid without expiration. Improvement Permit with site plan valid for sixty months. Authorization to Construct is valid for a period equal to that of Improvement Permit -- not to exceed sixty months.

Signed: M. Wood date — Installed by: Perry Laney (7/14/04)

Improvement Permit by: William O. Johnson date 8/29/03 Operation Permit by: William O. Johnson date 8/4/04

Authorization to Construct by: William O. Johnson date 8/29/03 Existing System Inspection by: — date —

HEALTH DEPT. COPY: WHITE OWNER COPY (FINAL): YELLOW OWNER COPY (INITIAL): PINK