3-30

IREDELL COUNTY HEALTH DEPARTMENT

THIS PERMIT REPLACES PREVIOUS ISSUED 7-28-2008

STATESVILLE 704-878-5305 @ MOORESVILLE 704-664-5281

IMPROVEMENT PERMIT / AUTHORIZATION TO CONSTRUCT / OPERATION PERMIT / EXISTING SYSTEM INSPECTION

PERMIT# 151535 PIN# 4730-55-0861 DATE 8-1-2008

OWNER OR APPLICANT NEW AMERICAN BUILDERS PHONE: Business 704-201-8855 Home

ADDRESS WILLIAMS ABERNATHY ROAD, MAIDEN, NC 28650

LOCATION US 21 S, TR PERTH, TR STATE PARK RD, TL TWIN CREEKS DR, TL WINDING CREEK, 8TH LOT ON LEFT

SUBDIVISION TWIN CREEKS BLOCK / SECTION II LOT 31 LOT AREA 0.93 SITE CLASS: PS DESIGN FLOW 360 L.T.A.R. 0.30 GPD/FT²

Septic Tank: 1000 Gallons; STB 794 Date 9-29-09

Pump Tank: 1000 Gallons; PT 27 Date 10-28-09

Pump Make: Gould Model WE05H Serial No.

Nitrification Field: No Fields 1 Square Feet 1200 Linear Feet 300

No Lines SIX Trench Width 36" Trench Bottom Depth 36" Gravel Depth N/A ☐ Gravity ☑ Pressure

☑ New System ☐ Repair ☐ Expansion System Type: I II IV V VI

System Description: 25% REDUCTION, pump

Repair System Description: 50% REDUCTION, LOW-PRESSURE

Maintenance Agreement Required: ☐ Yes ☑ No

☑ House/Mod. Home ☐ Mobile Home ☐ Business ☐ Other

No. Bedrooms 3 No. Persons No. Employees

Water Supply: ☐ Individual ☑ Public ☐ Community

☐ Slab ☐ Crawl Space ☑ Basement w/plumbing ☐ Basement wo/plumbing

Comments/Conditions: ① INSTALL INITAL SYSTEM TRENCHES ON CONTOUR AT 36" DEEP. ② SYSTEM SIZED FOR THREE BEDROOMS ONLY.

Comments/Conditions:

INITIAL SITE SKETCH

SEE ATTACHED "FAST TRACK" SITE PLAN PREPARED BY S&ME, INC DATED JULY 31, 2008

AS BUILT SKETCH

Permit can be suspended or revoked if any false information is supplied toward securing the permit/any unauthorized changes are made to the site/any unauthorized changes are made in the installation of the system. Improvement Permit with plat valid without expiration ☐ Improvement Permit with site plan valid for sixty months ☑ Authorization to Construct is valid for a period equal to that of Improvement Permit – not to exceed sixty months.

Signed: date 8/5

Improvement Permit by: STEVE HEDRICK date 8-1-2008

Authorization to Construct by: STEVE HEDRICK date 8-4-2008


Installed by: Russell Septic

Operation Permit by: date 3-14-11

Existing System Inspection by: date

HEALTH DEPT. COPY: WHITE OWNER COPY (FINAL): YELLOW OWNER COPY (INITIAL): PINK

SCALE: 1"=40'

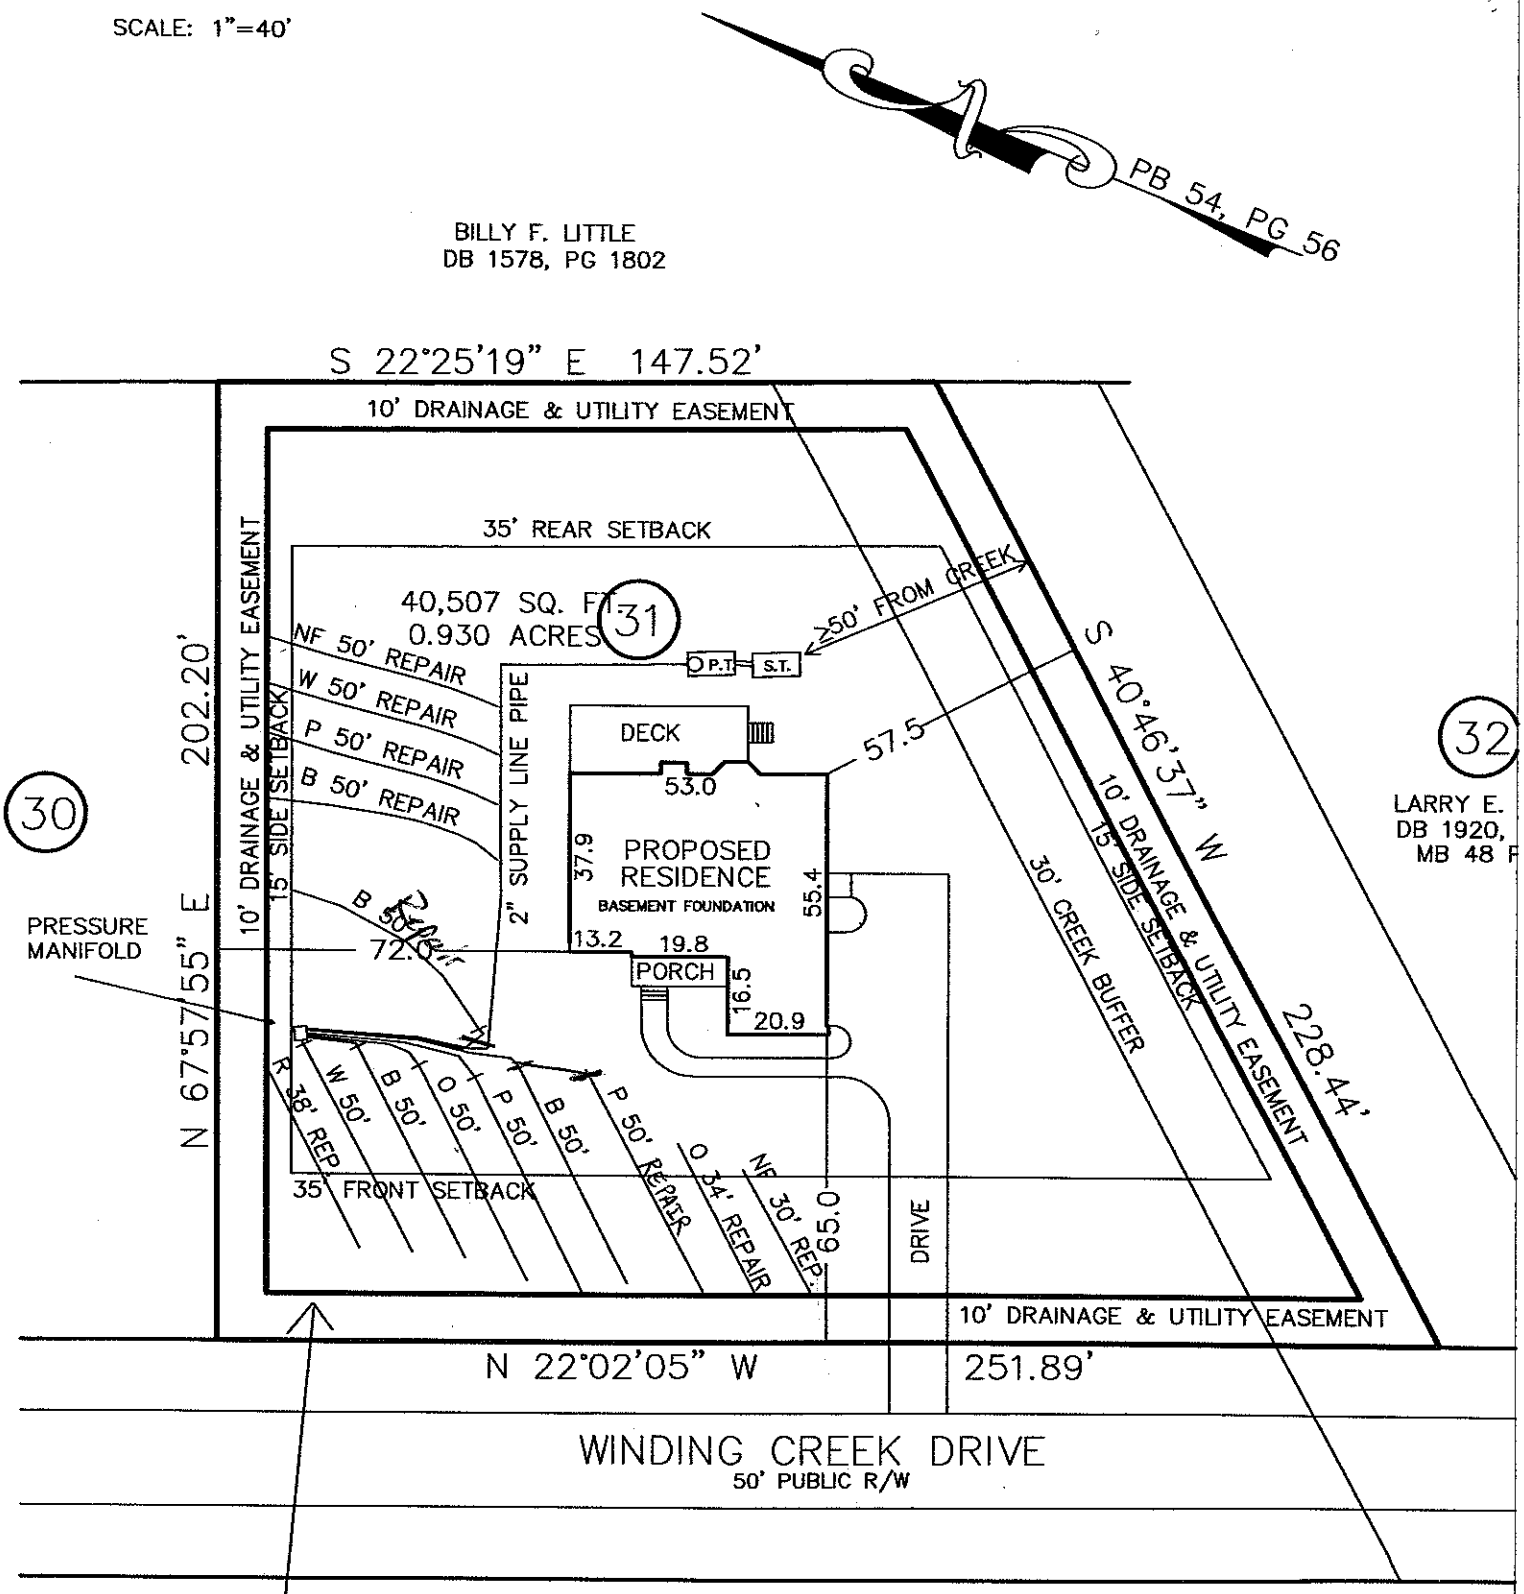

* KEEP SEPTIC LINES ≥15' FROM BANK CUT THAT IS 2'+

BASE MAP PROVIDED BY SURVEYOR. SEPTIC DETAILS ADDED BY S&ME, INC.