(CA) Dec 14 CLOSURE

IREDELL COUNTY HEALTH DEPARTMENT

STATESVILLE 704-878-5305 MOORESVILLE 704-664-5281

IMPROVEMENT PERMIT / AUTHORIZATION TO CONSTRUCT / OPERATION PERMIT / EXISTING SYSTEM INSPECTION

PERMIT# 141516 PIN# 4730557003 DATE 5-14-07

OWNER OR APPLICANT S&L Homes PHONE: Business 704-663-8467 Home

ADDRESS 110 CHARLESTON DR SUITE 108 MOORESVILLE NC 28117

LOCATION State Rd 2120 (1) TWIN CREEKS (2) WINDRUSH DR on Right BY END

SUBDIVISION TWIN CREEKS BLOCK / SECTION II LOT 45 LOT AREA .157 SITE CLASS. PS DESIGN FLOW 480 L.T.A.R. .35

Septic Tank: 1000 Gallons; STB 1607 Date 10/12/07
Pump Tank: Gallons; PT Date
Pump Make: Model 1605 Serial No. 535'
Nitrification Field: No Fields 1 Square Feet [redacted] Linear Feet [redacted]
No Lines 6 Trench Width 36" Max Trench Bottom Depth 19" Gravel Depth N/A

☒ New System ☐ Repair ☐ Expansion System Type: I (II) III IV V VI
System Description: CONVENTIONAL
Repair System Description: CP504, 2000 LF
Maintenance Agreement Required: ☐ Yes ☒ No

☒ House/Mod. Home ☐ Mobile Home ☐ Business ☐ Other
No. Bedrooms 4 No. Persons 6 No. Employees

Water Supply: ☐ Individual ☒ Public ☐ Community

☐ Slab ☒ Crawl Space ☐ Basement w/plumbing ☐ Basement wo/plumbing

☐ Gravity ☐ Pressure

Comments:/Conditions: 1) NOTE MAXIMUM TRENCH BOTTOM DEPTH OF 19" 2) KEEP HOUSE CUT OF GROUND & BACK FILL FOR POSITIVE DRAINAGE AWAY FROM SD REPAIR WILL NOT BE AFFECTED

Comments:/Conditions: Orange Baleg Filter ORIGINAL SYSTEM INSTALLED AS DRAWN

INITIAL SITE SKETCH

SEE ATTACHED SYSTEM DESIGN BY ROLLINS SOIL & ENVIRONMENTAL "FAST TRACK"

AS BUILT SKETCH

PAID NEW PERMIT FEE BECAUSE DURING FINAL DW SYSTEM REPAIR AREA WAS VIOLATED DUE TO DRIVEWAY. NEW REPAIR HAS TO BE REDESIGNED & IS ATTACHED IN THIS PERMIT PACKET 10-12-07

BUYER ACKNOWLEDGES Mark S. Kay SIGNATURE

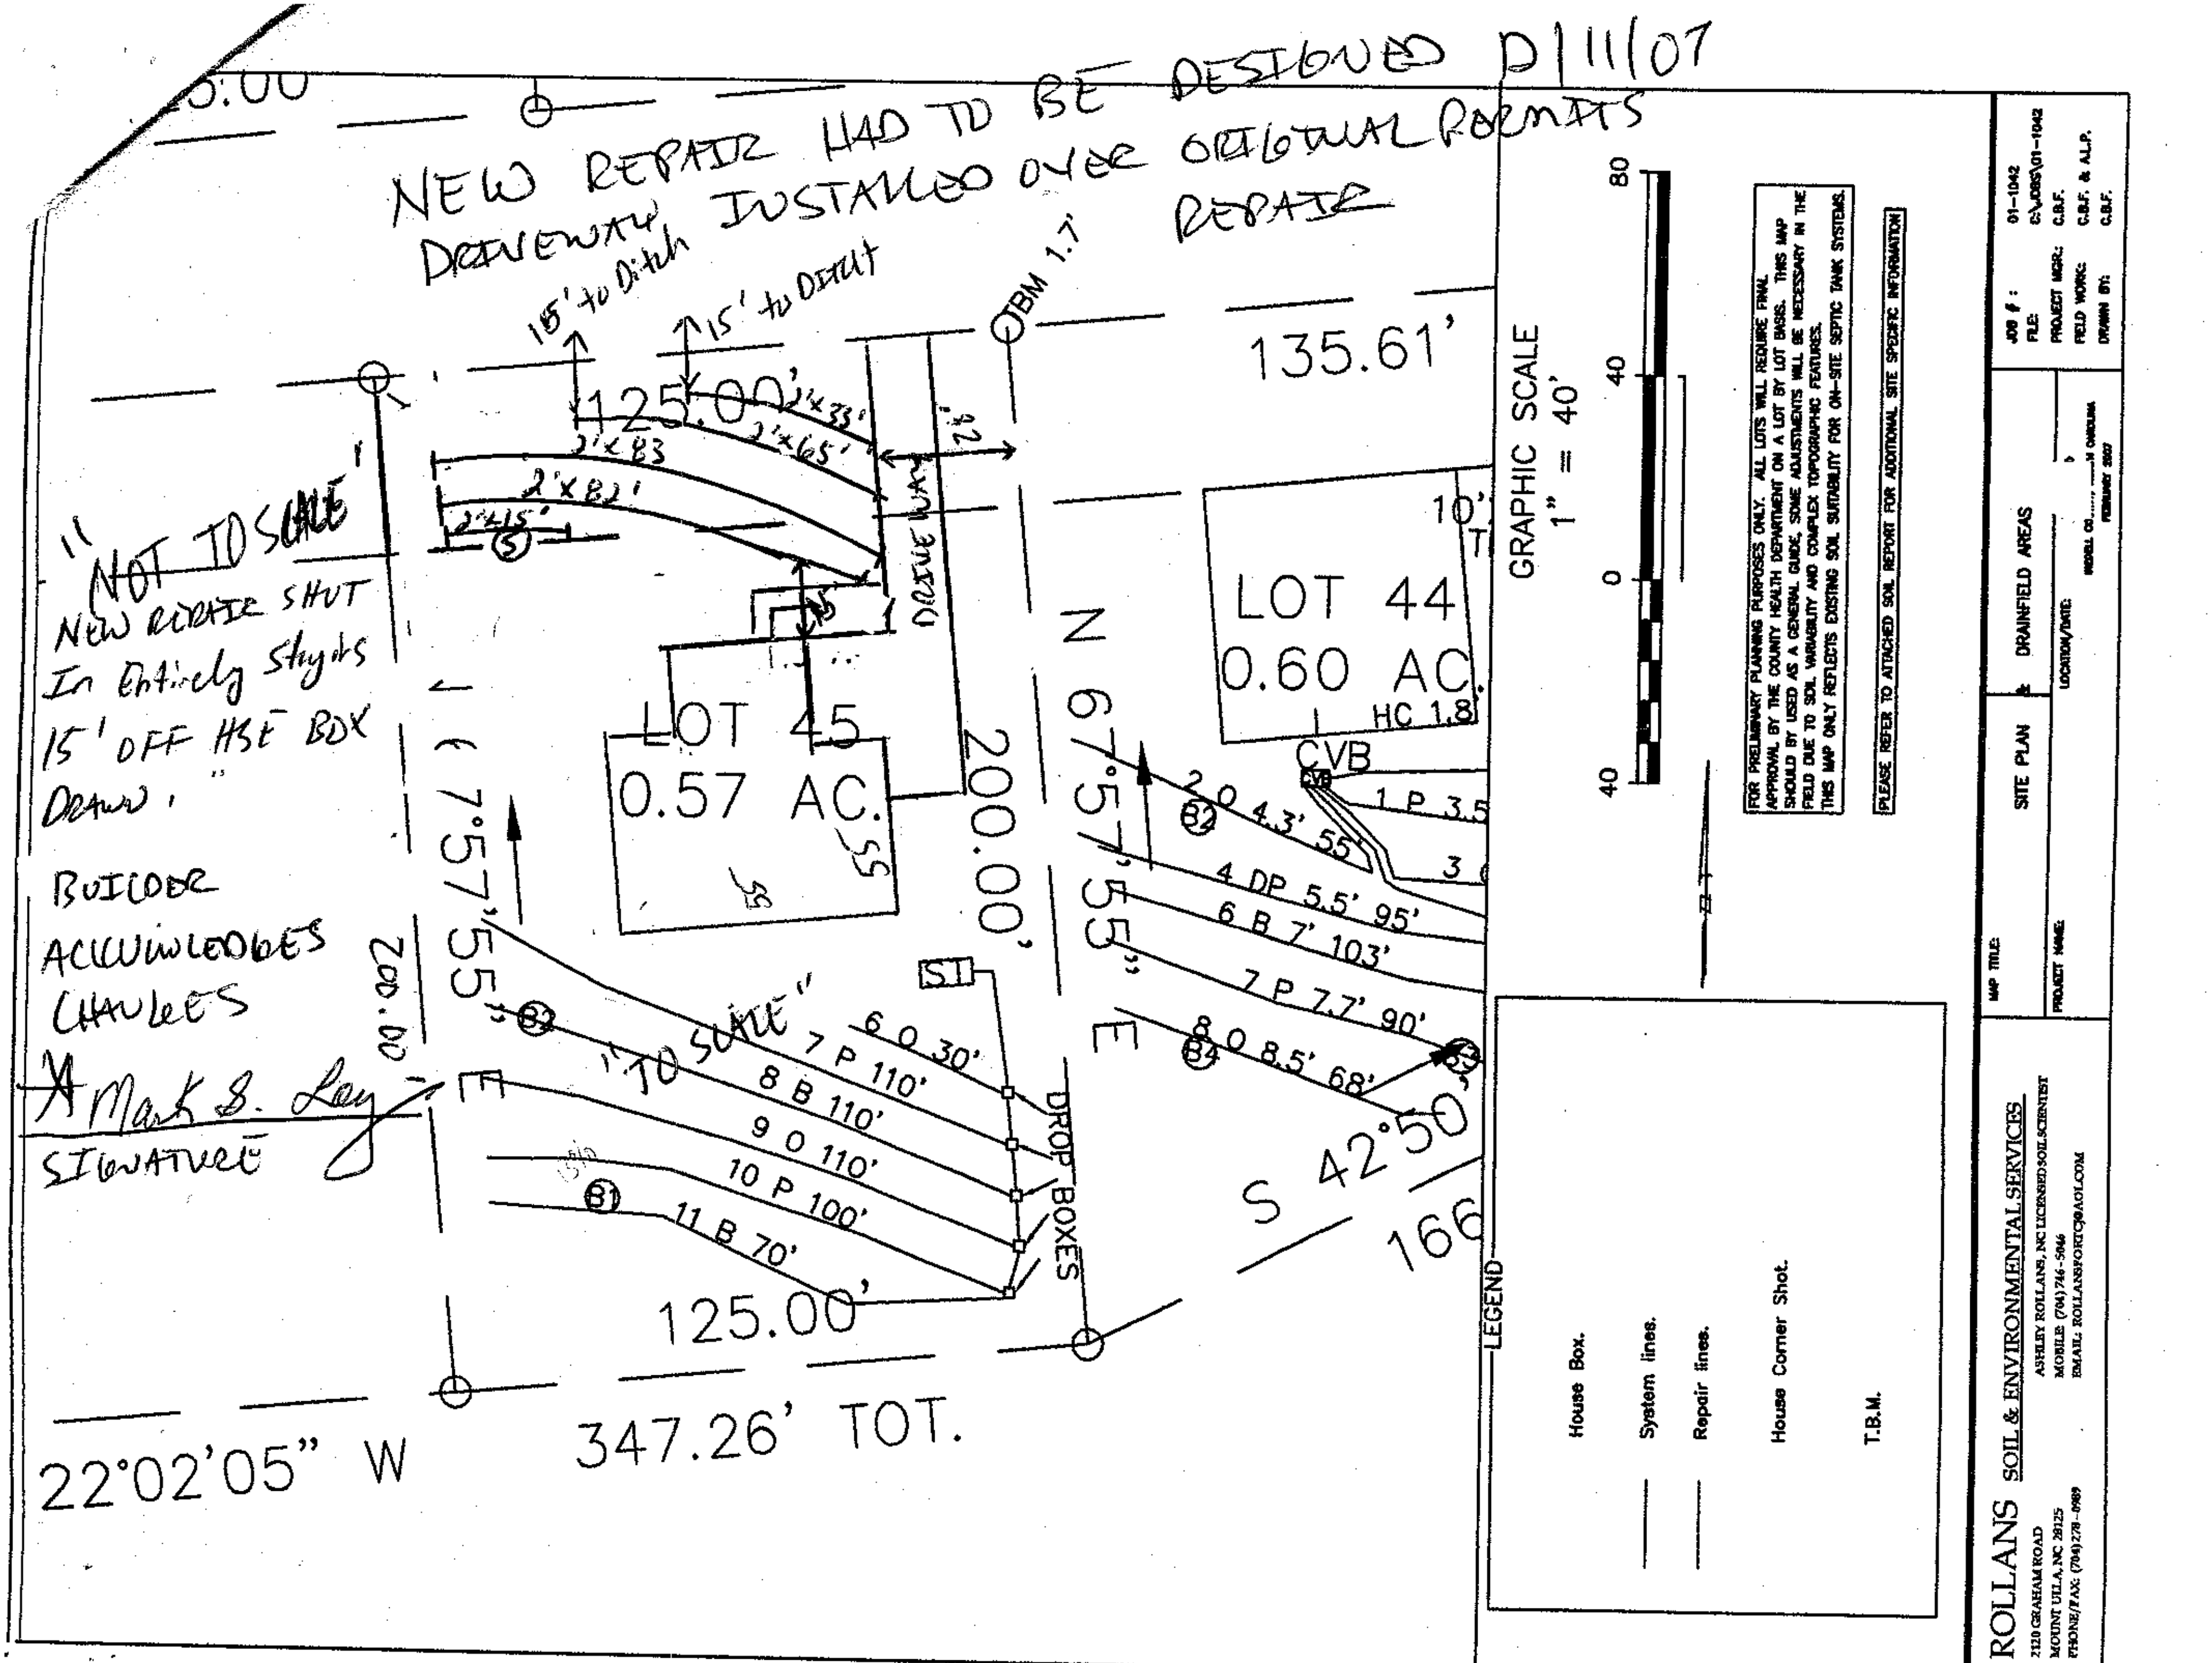
Permit can be suspended or revoked if any false information is supplied toward securing the permit/any unauthorized changes are made to the site/any unauthorized changes are made in the installation of the system. Improvement Permit with plat valid without expiration. ☐ Improvement Permit with site plan valid for sixty months ☒ Authorization to Construct is valid for a period equal to that of Improvement Permit – not to exceed sixty months.

Signed: Mark S. Kay date 5-16-07 Installed by: WAYNE CLONTZ

Improvement Permit by: [signature] date 5-14-07 Operation Permit by: [signature] date 12/12/07

Authorization to Construct by: [signature] date 5-14-07 Existing System Inspection by: date

HEALTH DEPT. COPY: WHITE OWNER COPY (FINAL): YELLOW OWNER COPY (INITIAL): PINK


NEW REPAIR HAD TO BE DESIGNED D|11|07
NEW REPAIR HAD TO BE DESIGNED DRIVEWAY INSTALLED OVER ORIGINAL PERMITS REPAIR
15' to Ditch
15' to Ditch
TBM 1.7'
135.61'
125.00'
2'x33'
2'x83
2'x65'
2'x82'
2'x15'
DRIVEWAY
"NOT TO SCALE"
NEW REPAIR SHUT IN ENTIRELY Staying 15' OFF HSE BOX DRAWN.
BUILDER ACKNOWLEDGES CHANGES
SIGNATURE
LOT 45
0.57 AC.
LOT 44
0.60 AC.
HC 1.8
CVB
200.00'
N 67°57'55" E
2 O 4.3' 55'
1 P 3.5
3
4 DP 5.5' 95'
6 B 7' 103'
7 P 7.7' 90'
8 O 8.5' 68'
B2
B3
B4
B1
ST
"TO SCALE"
6 O 30'
7 P 110'
8 B 110'
9 O 110'
10 P 100'
11 B 70'
DROP BOXES
S 42°50'
166
125.00'
347.26' TOT.
22°02'05" W
GRAPHIC SCALE
1" = 40'
80
40
0
40
FOR PRELIMINARY PLANNING PURPOSES ONLY. ALL LOTS WILL REQUIRE FINAL APPROVAL BY THE COUNTY HEALTH DEPARTMENT ON A LOT BY LOT BASIS. THIS MAP SHOULD BY USED AS A GENERAL GUIDE, SOME ADJUSTMENTS WILL BE NECESSARY IN THE FIELD DUE TO SOIL VARIABILITY AND COMPLEX TOPOGRAPHIC FEATURES. THIS MAP ONLY REFLECTS EXISTING SOIL SUITABILITY FOR ON-SITE SEPTIC TANK SYSTEMS.
PLEASE REFER TO ATTACHED SOIL REPORT FOR ADDITIONAL SITE SPECIFIC INFORMATION
LEGEND
House Box.
System lines.
Repair lines.
House Corner Shot.
T.B.M.
JOB #: 01-1042
FILE:
PROJECT MGR: C.B.F.
FIELD WORK: C.B.F. & A.L.P.
DRAWN BY: C.B.F.
MAP TITLE: SITE PLAN & DRAINFIELD AREAS
PROJECT NAME:
LOCATION/DATE:
ROLLANS SOIL & ENVIRONMENTAL SERVICES
ASHLEY ROLLANS, NC LICENSED SOIL SCIENTIST
2120 GRAHAM ROAD
MOUNT ULLA, NC 28125
MOBILE: (704) 746-5046
PHONE/FAX: (704) 278-0989