C1

IREDELL COUNTY HEALTH DEPARTMENT

STATESVILLE 704-878-5305 MOORESVILLE 704-664-5281

IMPROVEMENT PERMIT / AUTHORIZATION TO CONSTRUCT / OPERATION PERMIT / EXISTING SYSTEM INSPECTION

PERMIT# 138339 PIN# 4730-55-3170 DATE 10-4-06

OWNER OR APPLICANT FOOT HILL LAND & DEV. PHONE: Business 704-309-9173 Home

ADDRESS 52 River Pointe Ct Hickory NC 28601 → TWIN CREEKS

LOCATION Plateau RD (R) State Park (L) TWIN CREEKS (L) Winding Creek on LEFT

SUBDIVISION TWIN CREEKS BLOCK / SECTION II LOT 36 LOT AREA 0.6 SITE CLASS. PS DESIGN FLOW 480 L.T.A.R. .3

Septic Tank: 1000 Gallons; STB 825 Date 3-24-07

Pump Tank: Gallons; PT 302 Date 3-13-07

Pump Make: Model Serial No.

Nitrification Field: No Fields 1 Square Feet EA=1600 Linear Feet 400'

No Lines 4X100' Trench Width 36" Max Trench Bottom Depth 36'

☒ New System ☐ Repair ☐ Expansion System Type: I II (III) IV V VI

System Description: Pump 25% REDUCTION

Repair System Description: LPP 50% REDUCTION

Maintenance Agreement Required: ☐ Yes ☒ No

☒ House/Mod. Home ☐ Mobile Home ☐ Business ☐ Other

No. Bedrooms 4 No. Persons 8 No. Employees


Water Supply: ☐ Individual ☒ Public ☐ Community

Gravel Depth N/A ☐ Gravity ☒ Pressure ☐ Slab ☒ Crawl Space ☐ Basement w/plumbing ☐ Basement wo/plumbing


Comments/Conditions: ① Keep House Out of Ground & BACKFILL For Positive Drainage PERMITS ② INSTALL LINES ON CONTOURS & MAINTAIN SETBACKS ③ CALL Prior to installation FOR POND SIZING & System 1" = 40'

Comments/Conditions: SPECS IF NECESSARY. Blue tank-tile Pump tank-to Pond Septic tank-to house

INITIAL SITE SKETCH

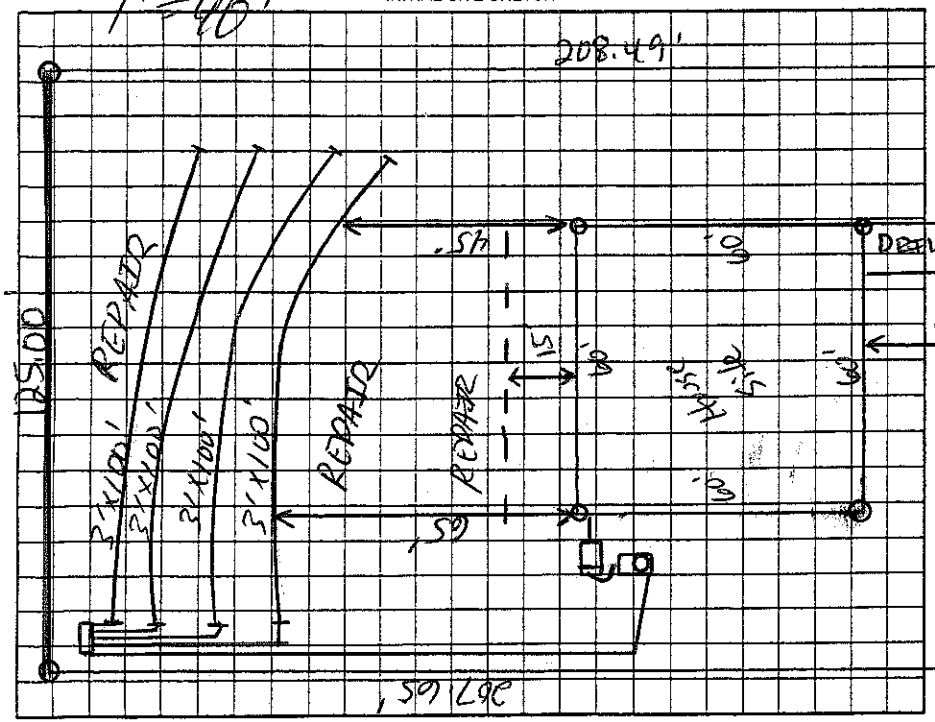

AS BUILT SKETCH

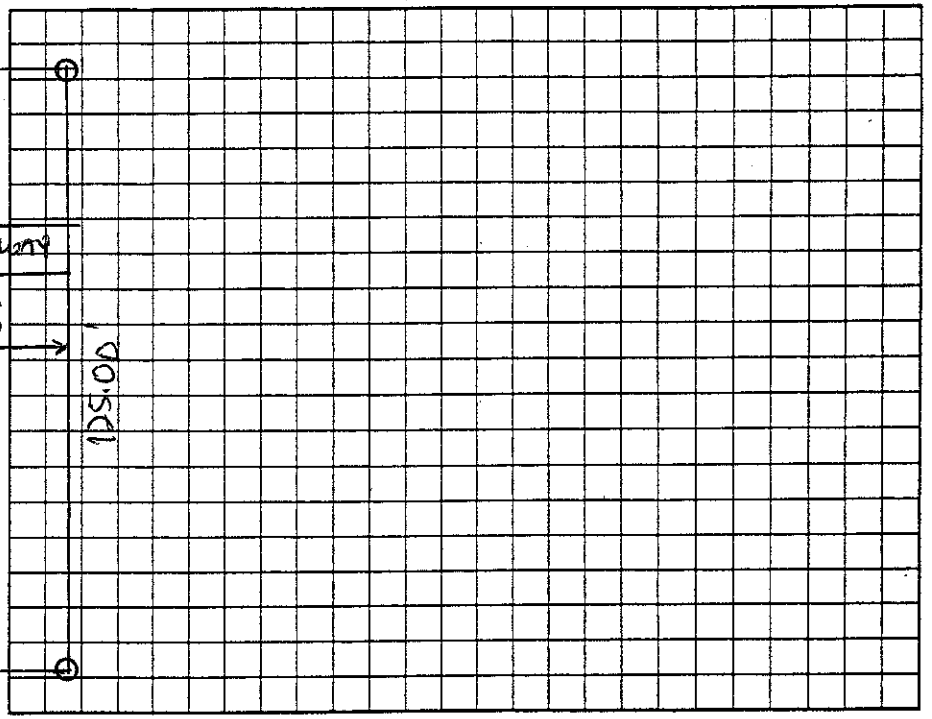

Permit can be suspended or revoked if any false information is supplied toward securing the permit/any unauthorized changes are made to the site/any unauthorized changes are made in the installation of the system. Improvement Permit with plat valid without expiration. ☐ Improvement Permit with site plan valid for sixty months ☒ Authorization to Construct is valid for a period equal to that of Improvement Permit – not to exceed sixty months.

Signed: date 10-11-06 Installed by: Rowan Septic

Improvement Permit by: date 10-4-06 Operation Permit by: R.S. date 29 Nov 07

Authorization to Construct by: date 10-26-06 Existing System Inspection by: date

HEALTH DEPT. COPY: WHITE OWNER COPY (FINAL): YELLOW OWNER COPY (INITIAL): PINK