45 48
54 54
102

3:00

IREDELL COUNTY HEALTH DEPARTMENT

STATESVILLE 704-878-5305 MOORESVILLE 704-664-5281

IMPROVEMENT PERMIT / AUTHORIZATION TO CONSTRUCT / OPERATION PERMIT / EXISTING SYSTEM INSPECTION

PERMIT# 138673 PIN# 4730-55-3212 DATE 11-7-06

OWNER OR APPLICANT KEMASABE LLC PHONE: Business 704-369-9173 Home 828-322-3280

ADDRESS 835 3RD AVE NW Hickory NC 28601

LOCATION 21 SOUTH (R) PORTH (R) STATE PARK RD (L) TWIN CREEKS (L) WINDRUSH CREEK GO LEFT

SUBDIVISION TWIN CREEKS BLOCK / SECTION II LOT 35 LOT AREA 1.05 AC SITE CLASS. PS DESIGN FLOW 480 L.T.A.R. 13

Septic Tank: 1000 Gallons; STB 825 Date 7-28-07
Pump Tank: Gallons; PT 302 Date 3-17-08
Pump Make: Zoeller Model N/152 Serial No.
Nitrification Field: No Fields 1 Square Feet EQ=1600 Linear Feet 400'
No Lines 4X100' Trench Width 36" Max Trench Bottom Depth 36"

☒ New System ☐ Repair ☐ Expansion System Type: I II III IV V VI
System Description: PUMP 25% REDUCTION
Repair System Description: LOW PRESSURE 50% REDUCTION
Maintenance Agreement Required: ☐ Yes ☒ No

☒ House/Mod. Home ☐ Mobile Home ☐ Business ☐ Other
No. Bedrooms 4 No. Persons 8 No. Employees

Water Supply: ☐ Individual ☒ Public ☐ Community


Gravel Depth N/A ☐ Gravity ☒ Pressure ☐ Slab ☒ Crawl Space ☐ Basement w/plumbing ☐ Basement wo/plumbing

Comments/Conditions: (1) Keep House Out of Ground + BACKFILL For Positive Drainage Reports (2) INSTALL LATCHES ON CONTAINS & MAINTAIN SETBACKS; (3) GRADE OUT OLD FIELD TERRACE


Comments/Conditions: Approved 54' wide x 48' DEEP House PLAN Keeping TANKS IN SAME LOCATION + NEW SETBACKS ARE 48' OFF P/L, 54' HOUSE & 23' for side entry GARAGE; BUILDER RICHARD ON 2/26/07 JAVI CHAVEZ

1"=50'

INITIAL SITE SKETCH

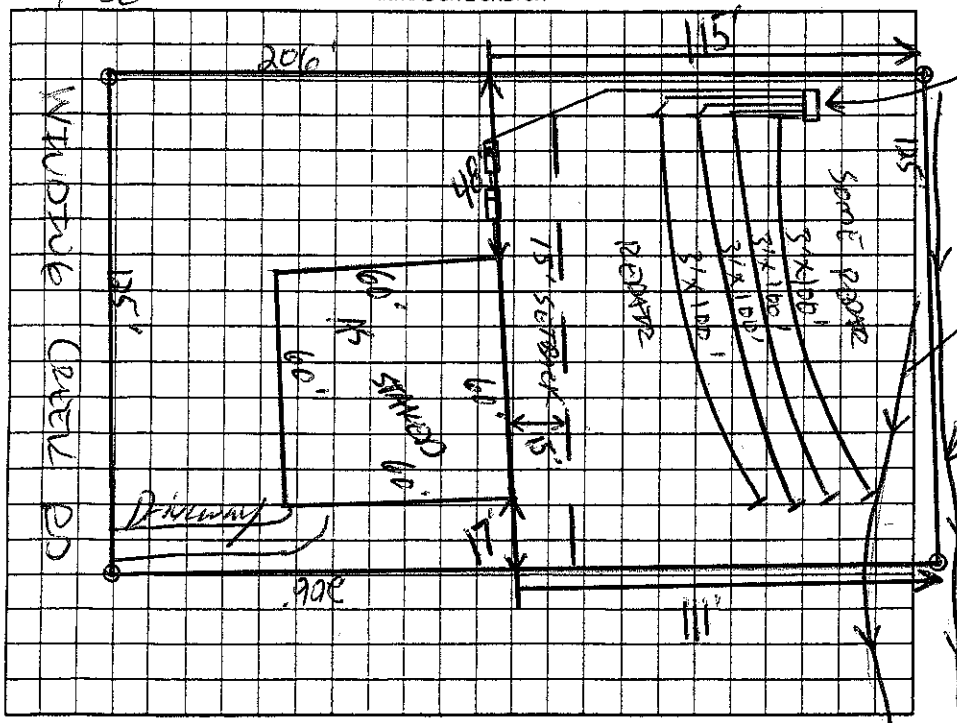

AS BUILT SKETCH

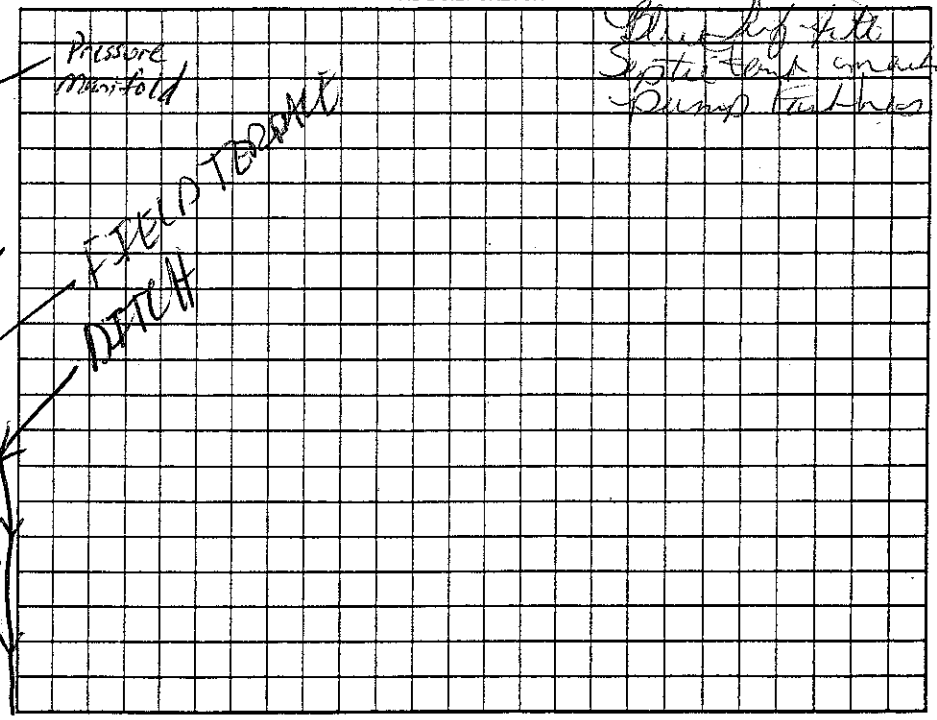

Permit can be suspended or revoked if any false information is supplied toward securing the permit/any unauthorized changes are made to the site/any unauthorized changes are made in the installation of the system. Improvement Permit with plat valid without expiration ☐ Improvement Permit with site plan valid for sixty months ☒ Authorization to Construct is valid for a period equal to that of Improvement Permit – not to exceed sixty months.

Signed: date

Improvement Permit by: date 11-7-06

Authorization to Construct by: date 2-26-07

Installed by: ROWAN Septic

Operation Permit by: , R.S. date 7.1.07

Existing System Inspection by: date

HEALTH DEPT. COPY: WHITE OWNER COPY (FINAL): YELLOW OWNER COPY (INITIAL): PINK