# IREDELL COUNTY HEALTH DEPARTMENT

Statesville Office (704) 878-5305 Mooresville Office (704) 660-3625 PERMIT # 176690

## IMPROVEMENT PERMIT / AUTHORIZATION TO CONSTRUCT / OPERATION PERMIT / EXISTING SYSTEM

PIN # 4730559738

APPLICANT: Billy Franklin Little, Jr. APPLICANT ADDRESS: 1014 Perth Road

SITE ADDRESS: 1006 Perth Road PHONE: 704 528 5625 ALT. PHONE: 704 880 5068

SITE DIRECTIONS: Hwy 21S, (L) (R) on Perth, lot on right behind 1006 Perth


SUBDIVISION: n/a SECTION: n/a LOT # n/a LOT AREA: 1.483 DESIGN FLOW: 360 L.T.A.R.: .25

| | | | | | | | | | |
|---|---|---|---|---|---|---|---|---|---|
| Septic Tank | 1000 | (gal) | STB | Date | | [X] New System [ ] Repair [ ] Expansion | System Type: I II (III) IV V VI | [X] Residence | No. Bedrooms 3 |
| Pump Tank | | (gal) | PT | Date | | System Description: 25% Reduction Gravity | | [ ] Business | No. Persons |
| Pump Make | | Model | | Serial # | | Repair System Description: 25% Reduction Gravity | | [ ] Other | No. Employees |
| # Nitrification Fields | 1 | # Lines | 3 | Linear Ft: | 360 | Maintenance Agreement Required: [ ] YES [X] NO | | [ ] Slab | [X] Crawl Space |
| Trench Width | 36" | Max. Trench Bottom Depth | 36" | Gravel Depth | n/a | [X] GRAVITY [ ] PRESSURE | | [ ] Basement w/plumbing | [ ] Basement w/o plumbing |

Water Supply: [X] Private [ ] Public [ ] Community

Comments / Conditions:

INITIAL SITE SKETCH

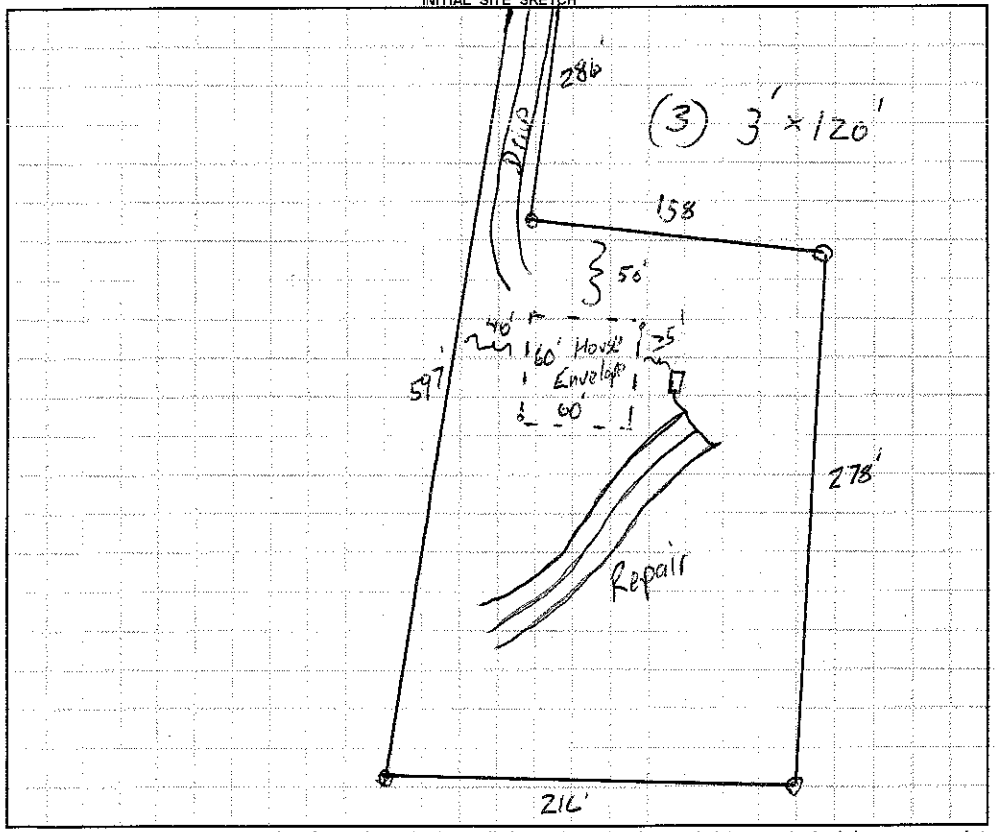


AS BUILT SKETCH

*Permit can be suspended or revoked if any false information is supplied toward securing the permit / any unauthorized changes are made to the site / any unauthorized changes are made in the installation of the system.* **CONTACT A LOCATOR SERVICE PRIOR TO ANY EXCAVATION**

[ ] **IMPROVEMENT PERMIT** *with ~~plat~~ valid without expiration.* [X] **IMPROVEMENT PERMIT** *with site plan valid for 60 mos.* [X] **AUTHORIZATION TO CONSTRUCT** *valid for period equal to IMPROVEMENT PERMIT--not to exceed 60 mo.*

Owner / Applicant Signature: Billy Little Date: 4-23-13 Installed by: Orbison

IMPROVEMENT PERMIT by: James Long Date: 2-11-14 OPERATION PERMIT by: BA Cox CHECKED Date: APR 02 2014

AUTHORIZATION TO CONSTRUCT by: James Long Date: 4-23-13 Existing System Inspected by: Date:

Health Dept. Copy - WHITE Applicant (Final Approval) - YELLOW Applicant (Conditional Approval) - PINK