IREDELL COUNTY HEALTH DEPARTMENT

STATESVILLE 704-878-5305 CI MOORESVILLE 704-664-5281

IMPROVEMENT PERMIT / AUTHORIZATION TO CONSTRUCT / OPERATION PERMIT / EXISTING SYSTEM INSPECTION

PERMIT# 21738 PIN# 4730-56-6044.001 8152 DATE 6-22-04

OWNER OR CONTRACTOR CRAIG HUTCHENS PHONE: Business 704-902-0042 Home

ADDRESS 3552 CARINGTON LANE STATESVILLE, NC 28625

LOCATION PERTH RD SOUTH (12) BETWEEN 5TH & 6TH HOUSE & BEHIND THEM

SUBDIVISION BLOCK / SECTION LOT LOT AREA 1.0 SITE CLASS. PS DESIGN FLOW 360 L.T.A.R. .3

Septic Tank: 1000 Gallons; STB 1012 Date 11-19-04

Pump Tank: Gallons; PT Date

Pump Make: Model Serial No. 300

Nitrification Field: No Fields 1 Square Feet 1200' Linear Feet 400'

No Lines 4 Trench Width 36" Max Trench Bottom Depth 22" Gravel Depth 12"

☒ New System ☐ Repair System Type: I, II, III, IV, V, VI

System Description: ~~GRAV CONV~~ GRAV 3591 RED

Repair System Description: GRAV 3591 RED

Maintenance Agreement Required: ☐ Yes ☒ No

☒ House/Mod. Home No. Bedrooms 3

☐ Mobile Home No. Bathrooms 2

☐ Business No. Employees

☐ Other


☐ Slab ☐ Crawl Space ☒ Basement w/plumbing ☐ Basement wo/plumbing

Water Supply: ☒ Individual ☐ Public ☐ Community WELL


Comments:/Conditions: ~~X~~ (1) NOTE MAXIMUM TRENCH BOTTOM DEPTH OF 22" & BASEMENT COMMENTS ABOUT NATURAL GRADE AT BACK OF HOME. (2) INSTALL LINES ON CONTOURS. (3) MAINTAIN SETBACKS

Comments:/Conditions: JUFFTIRE FILTER & MARKER

INITIAL SITE SKETCH

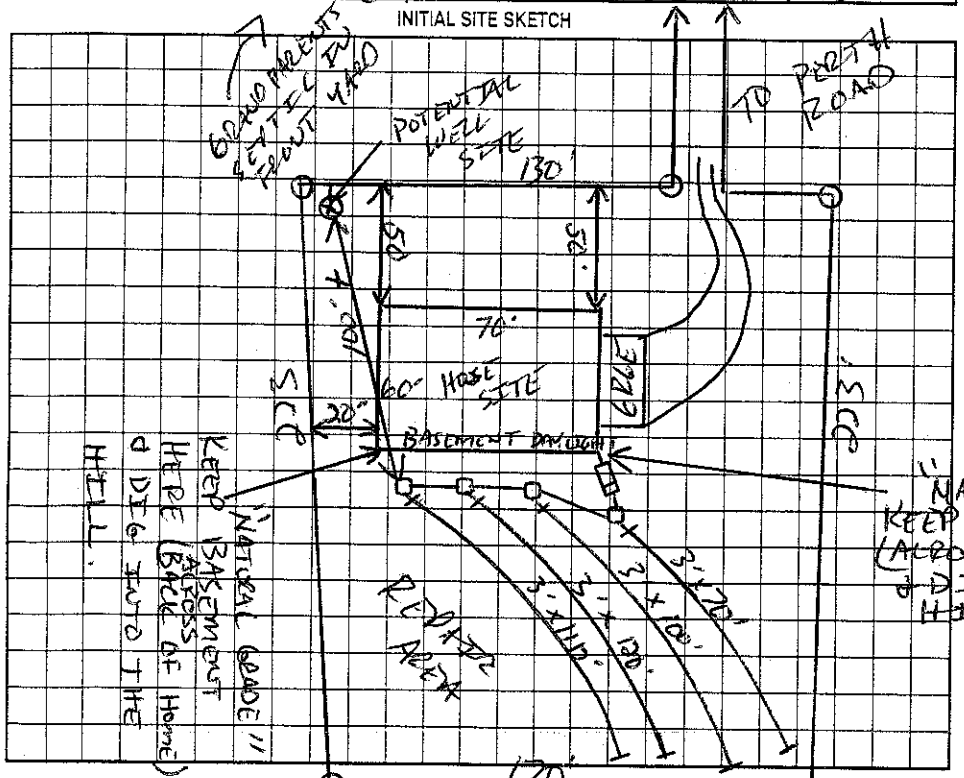

AS BUILT SKETCH

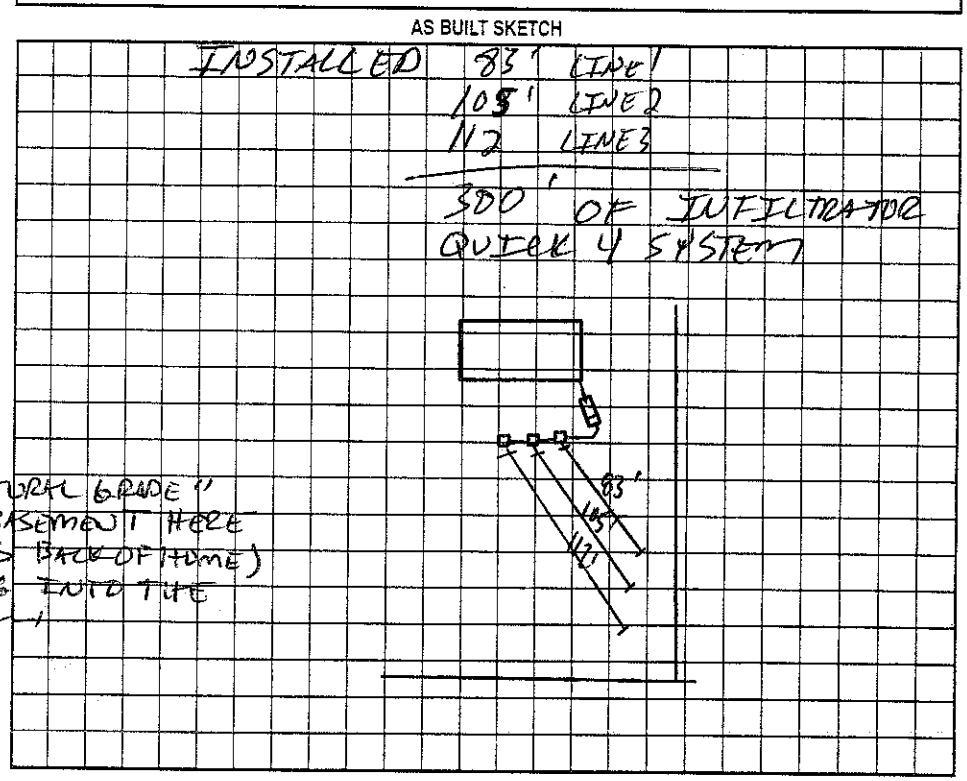

Permit can be suspended or revoked if any false information is supplied toward securing the permit/any unauthorized changes are made to the site/any unauthorized changes are made in the installation of the system. Improvement Permit with plat valid without expiration. Improvement Permit with site plan valid for sixty months. Authorization to Construct is valid for a period equal to that of Improvement Permit – not to exceed sixty months.

Signed: Craig Hutchens date 6-23-04 Installed by: DAVID YOUNTZ

Improvement Permit by: date 6-22-04 Operation Permit by: date 6-7-05

Authorization to Construct by: date 6-22-04 Existing System Inspection by: date

HEALTH DEPT. COPY: WHITE OWNER COPY (FINAL): YELLOW OWNER COPY (INITIAL): PINK