C + S Assoc.

$ 300 pd 7-3-01

IREDELL COUNTY HEALTH DEPARTMENT

STATESVILLE 704-878-5305 MOORESVILLE 704-664-5281

IMPROVEMENT PERMIT / AUTHORIZATION TO CONSTRUCT / OPERATION PERMIT / EXISTING SYSTEM INSPECTION

PERMIT# 19-2-699 PIN# 4730-48-6413 DATE July 3, 01

OWNER OR CONTRACTOR Dixieland Inc PHONE: Business 202-4971 Home

ADDRESS 4474 Lake Dr. Sherrills Ford, N.C.

LOCATION State Park Rd. TR into Meadow Glen TL 1st street (Shenandoah Loop) on left

SUBDIVISION Meadow Glen BLOCK / SECTION II LOT 30 LOT AREA .3806 + SFE SITE CLASS PS w/SFE DESIGN FLOW 360 gpd L.T.A.R. .3

Septic Tank: 1800 Gallons: STB 825 Date 4-1-01

Pump Tank: 1000 Gallons: PT 302 Date 5-3-01

Pump Make: Coulds Model WE0311C Serial No E0129905

Nitrification Field: No Fields 2 Square Feet 400 Linear Feet 200

No Lines 4@50' Trench Width 24" 8'oc Max Trench Bottom Depth 30"

☑ New System ☐ Repair System Type: I. II (III) IV. V. VI

System Description: Dual pm - PPBPS

Repair System Description: LP PPBPS

Maintenance Agreement Required: ☐ Yes ☑ No initially

Gravel Depth N/A

☐ Slab ☐ Crawl Space ☑ Basement w/plumbing ☐ Basement wo/plumbing

☑ House/Mod Home No. Bedrooms 3

☐ Mobile Home No. Bathrooms 2

☐ Business No Employees

☐ Other


Water Supply: ☐ Individual ☑ Public ☐ Community

Comments/Conditions: Permit issued 8-16-99 voided due to non compliance of house.


Comments/Conditions Checked PM. + Electrical Inspection Okay. ok Installed 200' PPBPS System. ok - Cover Installed over Check Valve

1"=50'

INITIAL SITE SKETCH

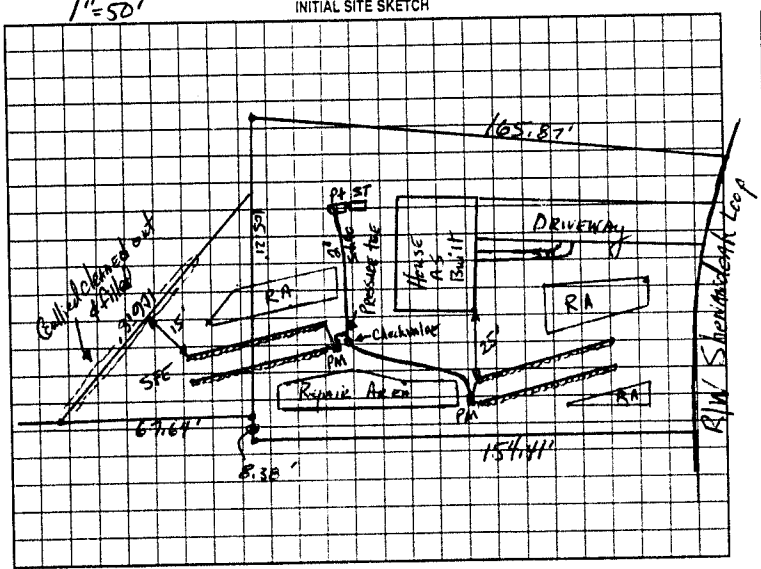

AS BUILT SKETCH

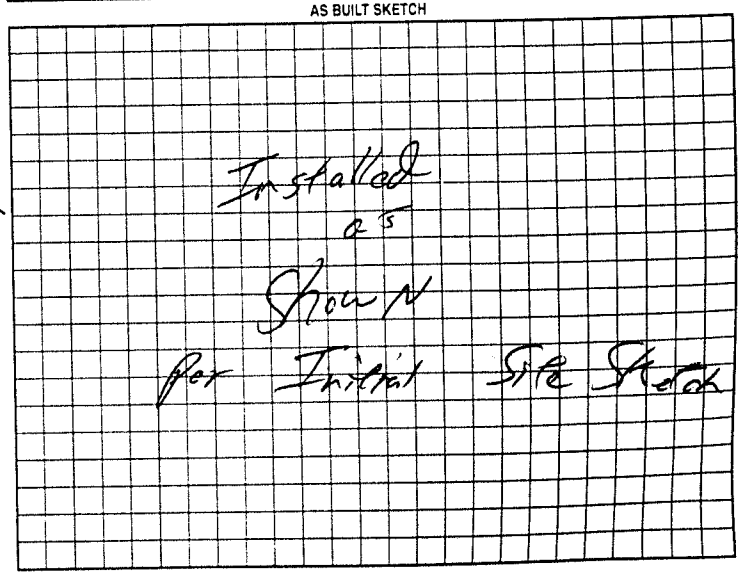

Permit can be suspended or revoked if any false information is supplied toward securing the permit/any unauthorized changes are made to the site/any unauthorized changes are made in the installation of the system. Improvement Permit with plat valid without expiration. Improvement Permit with site plan valid for sixty months. Authorization to Construct is valid for a period equal to that of Improvement Permit – not to exceed sixty months.

Signed: * Jennifer Cogdill date

Improvement Permit by: Harold Hinson, RS date 7-03-01

Authorization to Construct by: Harold Hinson, RS date 7-03-01

Installed by: Low on Septic date

Operation Permit by: Cathleen O. Johnson date 7/7/01

Existing System Inspection by: date

HEALTH DEPT COPY: WHITE OWNER COPY (FINAL): YELLOW OWNER COPY (INITIAL): PINK