IREDELL COUNTY HEALTH DEPARTMENT

STATESVILLE 704-878-5305 MOORESVILLE 704-664-5281

IMPROVEMENT PERMIT / AUTHORIZATION TO CONSTRUCT / OPERATION PERMIT / EXISTING SYSTEM INSPECTION

PERMIT# 24-2-699 8364 PIN# 4730-48-6413 DATE July 28, '99

OWNER OR CONTRACTOR Spear Construction // C&S Assoc. PHONE: Business (704) 361-7518 / 336-475-4111 Home

ADDRESS 607 Enderby Ave., Salisbury 28144 // 904 Salem St. Thomasville 27360

LOCATION Trantman, Perth Rd. South, TR State Park TR Meadow Glen Drive TR Meadow Glen Circle on Right

SUBDIVISION Meadow Glen BLOCK / SECTION LOT 37 LOT AREA .3832 Ac SITE CLASS 15 DESIGN FLOW 360gpd L.T.A.R. .83

Septic Tank: 1000 Gallons; STB 825 Date 7-11-99
Pump Tank: 1000 Gallons; PT 302 Date 7 20 99
Pump Make: Zoeller Model Solar 4137 Serial No.
Nitrification Field: No Fields 1 Square Feet 900 Linear Feet 300
No Lines 3 @ 100' Trench Width 36" Max Trench Bottom Depth 36" Gravel Depth NA

☑ New System ☐ Repair System Type: I. II. III. IV. V. VI
System Description: PM- Inovative -25% Reduction
Repair System Description: LP Panel Block
Maintenance Agreement Required: ☐ Yes ☑ No initially

☑ House/Mod. Home No. Bedrooms 3
☐ Mobile Home No. Bathrooms 2
☐ Business No. Employees
☐ Other

☑ Slab ☐ Crawl Space ☐ Basement w/plumbing ☐ Basement wo/plumbing


Water Supply: ☐ Individual ☑ Public ☐ Community

Comments/Conditions: * ONE Inspection port per Lateral
Some potential repair area exists behind house immediately below tanks and driveway // water line area.


Comments/Conditions: Lines inspected 8-31-99 Installed as shown
9-21 pump checked Lines flushed
9-22 Driveway initially installed over ends of septic line Was removed and placed 5ft from End of Lines. Shown As Installed

1"=50'

INITIAL SITE SKETCH

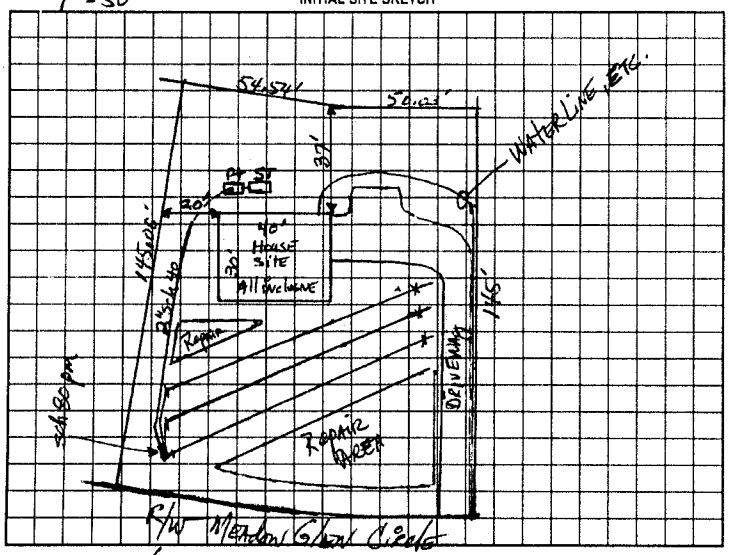

AS BUILT SKETCH

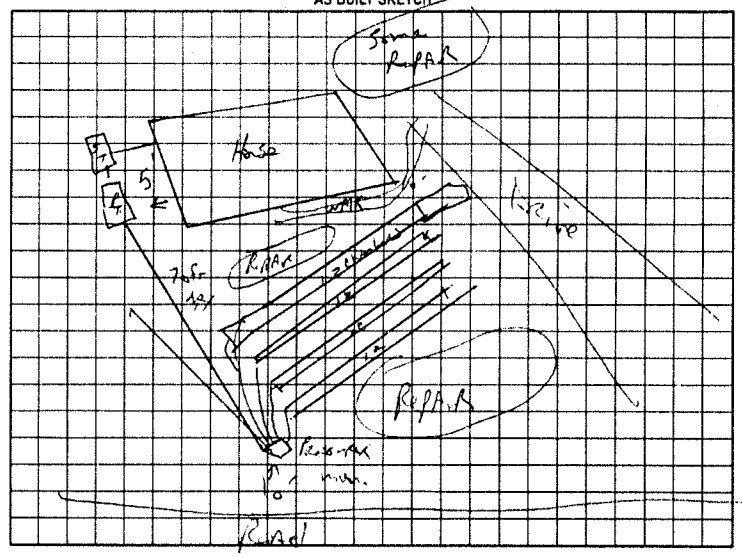

Permit can be suspended or revoked if any false information is supplied toward securing the permit/any unauthorized changes are made to the site/any unauthorized changes are made in the installation of the system. Improvement Permit with plat valid without expiration. Improvement Permit with site plan valid for sixty months. Authorization to Construct is valid for a period equal to that of Improvement Permit – not to exceed sixty months.

Signed:

Improvement Permit by: date 7-28-99

Authorization to Construct by: date 7-28-99

Installed by: Rowan Septic

Operation Permit by: C. Potter date Sept 22-99.

Existing System Inspection by: date

HEALTH DEPT COPY WHITE OWNER COPY (FINAL) YELLOW OWNER COPY (INITIAL) PINK