90567 5:30

IREDELL COUNTY HEALTH DEPARTMENT

STATESVILLE 704-878-5305 MOORESVILLE 704-664-5281

IMPROVEMENT PERMIT / AUTHORIZATION TO CONSTRUCT / OPERATION PERMIT / EXISTING SYSTEM INSPECTION

PERMIT# 18-7-699 PIN# 4730486413 C&S Const. DATE 8/13/99

OWNER OR CONTRACTOR Max Spears Construction PHONE: Business 361-7518 Home

ADDRESS 607 Anderson Ave Salisbury, NC 28144

LOCATION State Park Rd TR Meadow Glen Dr TL Meadow Glen Circle

SUBDIVISION Meadow Glen BLOCK / SECTION LOT 29 LOT AREA .3954 Acre SITE CLASS PS DESIGN FLOW 360 gpd L.T.A.R. .3

Septic Tank: 1000 Gallons; STB ~~825~~ RST Date 6-15-00

Pump Tank: Gallons; PT ~~350~~ RST Date 6-11-00

Pump Make: Model Serial No.

Nitrification Field: No Fields 1 Square Feet 900' Linear Feet 300'

No Lines 3 at 100' Trench Width 36" Max Trench Bottom Depth 36" Gravel Depth N/A

[X] New System [ ] Repair System Type: I II (III) IV V VI

System Description: Pump - 25% Reduction

Repair System Description: Pump - Panel Blk

Maintenance Agreement Required: [ ] Yes [X] No

[X] House/Mod. Home [ ] Mobile Home [ ] Business [ ] Other

No. Bedrooms 3 No. Bathrooms 2 No. Employees

[X] Slab [X] Crawl Space [ ] Basement w/plumbing [ ] Basement wo/plumbing


Water Supply: [ ] Individual [X] Public [ ] Community

Comments/Conditions: Keep Septic System at least 10' from PL & 5' from House

Comments/Conditions: 8-1-00 Checked tanks, lines & pressure DRH. Need to check Alarm, elec. hookup & valve for basement coverage. Also check for rope on pump. DRH

Scale 1:50

INITIAL SITE SKETCH

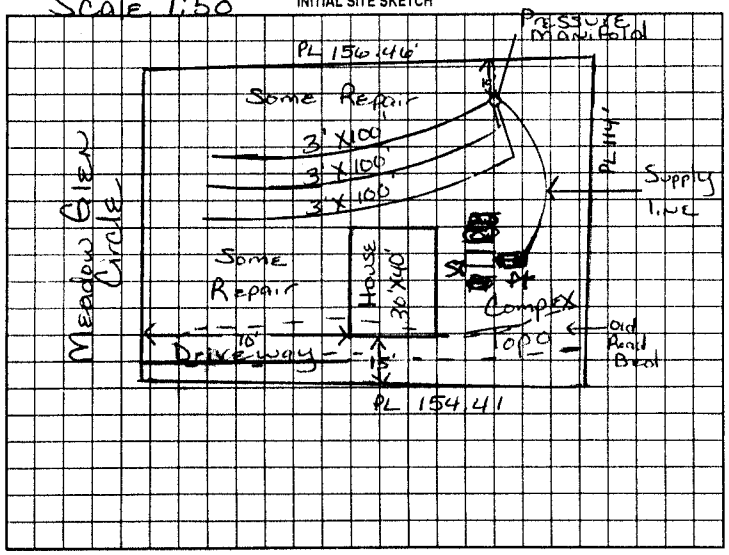

AS BUILT SKETCH

Drainfield Installed Systems Tanks As Shown. Tanks set in line.

Permit can be suspended or revoked if any false information is supplied toward securing the permit/any unauthorized changes are made to the site/any unauthorized changes are made in the installation of the system. Improvement Permit with plat valid without expiration. Improvement Permit with site plan valid for sixty months. Authorization to Construct is valid for a period equal to that of Improvement Permit – not to exceed sixty months.

Signed: [signature] date 8/30/99 Installed by: Rowan Septic Tank

Improvement Permit by: Maria H Dotson RS date 8/13/99 Operation Permit by: C. Bly RS date 10/5/00

Authorization to Construct by: Maria Dotson RS date 8/13/99 Existing System Inspection by: date

HEALTH DEPT COPY WHITE OWNER COPY (FINAL) YELLOW OWNER COPY (INITIAL) PINK