IREDELL COUNTY HEALTH DEPARTMENT

STATESVILLE 704-878-5305 MOORESVILLE 704-664-5281

IMPROVEMENT PERMIT / AUTHORIZATION TO CONSTRUCT / OPERATION PERMIT / EXISTING SYSTEM INSPECTION

(4:00)

PERMIT# 07-2-0100 PIN# 4736572810 DATE Feb 14, 2000

OWNER OR CONTRACTOR Ray Short 203 W Laces Rd Mrsvl 28117 PHONE: Business 202-5508 Home

ADDRESS

LOCATION Perth Rd. N. TL State Park Rd. TR 1st Street into Meadow Glen TL 1st Street on left

SUBDIVISION Meadow Glen BLOCK / SECTION LOT 28 LOT AREA .4067 Ac SITE CLASS PS DESIGN FLOW 360 gpd L.T.A.R. .3

Septic Tank: 1000 Gallons; STB 625 Date 5/4/00
Pump Tank: Gallons; PT Date
Pump Make: Model Serial No.
Nitrification Field: No Fields 1 Square Feet 900 Linear Feet 300
No Lines 5@60' Trench Width 36" Max Trench Bottom Depth 36"

☑ New System ☐ Repair System Type: I, II, III, IV, V, VI
System Description: Gravity Innovative - 35% Reduction
Repair System Description: Gravity Panel Block
Maintenance Agreement Required: ☐ Yes ☑ No

☑ House/Mod. Home No. Bedrooms 3
☐ Mobile Home No. Bathrooms 2
☐ Business No. Employees
☐ Other

☐ Slab ☑ Crawl Space ☐ Basement w/plumbing ☐ Basement wo/plumbing


Water Supply: ☐ Individual ☑ Public ☐ Community

Comments/Conditions: ONE inspection report for LATERAL. Remove old Burem/Helgerson


Comments/Conditions:

1"=50'

INITIAL SITE SKETCH

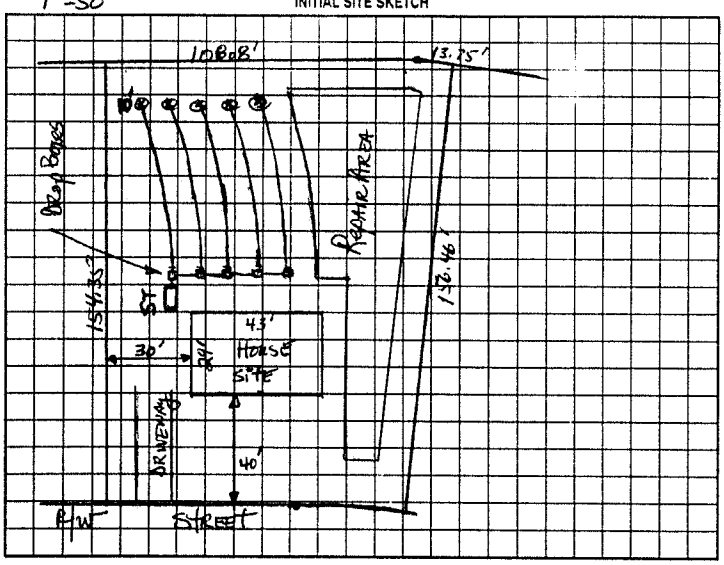

AS BUILT SKETCH

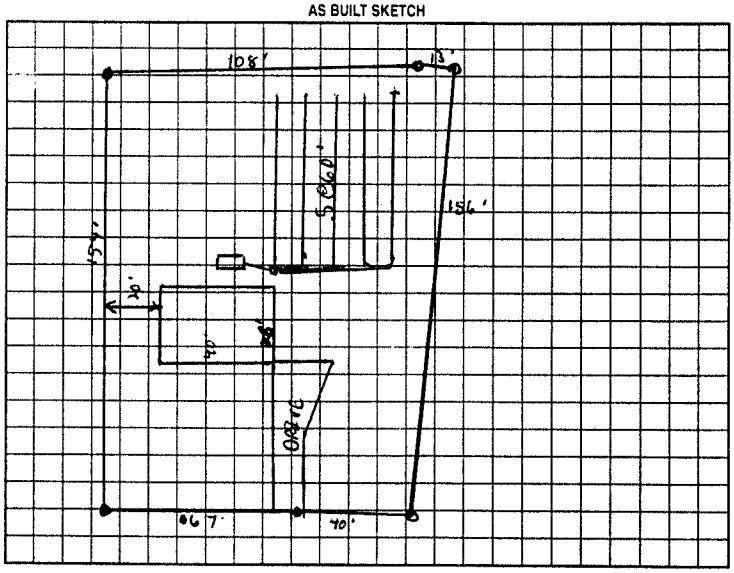

Permit can be suspended or revoked if any false information is supplied toward securing the permit/any unauthorized changes are made to the site/any unauthorized changes are made in the installation of the system. Improvement Permit with plat valid without expiration. Improvement Permit with site plan valid for sixty months. Authorization to Construct is valid for a period equal to that of Improvement Permit – not to exceed sixty months.

Signed: date 2/23/00 Installed by: WAYNE CLONTZ

Improvement Permit by: RS date 2-14-2000 Operation Permit by: RS date 6/23/00

Authorization to Construct by: RS date 2-14-2000 Existing System Inspection by: date

HEALTH DEPT. COPY: WHITE OWNER COPY (FINAL): YELLOW OWNER COPY (INITIAL): PINK