IREDELL COUNTY HEALTH DEPARTMENT

STATESVILLE 704-878-5305 MOORESVILLE 704-664-5281

IMPROVEMENT PERMIT / AUTHORIZATION TO CONSTRUCT / OPERATION PERMIT / EXISTING SYSTEM INSPECTION

PERMIT# 01 2 1898 ~~Trout~~ PIN# 4730 48 6343 DATE 10-17-98

OWNER OR CONTRACTOR Ginger Cecil Cts Assoc. PHONE: Business 336 475 4111 Home

ADDRESS 904 Salem St. Thomasville, N.C. 27360

LOCATION Perth ch Rd TR State Pk Rd 1/8 mi Rt.

SUBDIVISION Meadow Glen BLOCK / SECTION LOT 25 LOT AREA 16900 sq' SITE CLASS P5 DESIGN FLOW 360 L.T.A.R. .3

Septic Tank: 1000 Gallons: STB 825 Date 1-3-00
Pump Tank: Gallons: PT Date
Pump Make: Model Serial No
Nitrification Field: No Fields 1 Square Feet 900 Linear Feet 300
No Lines 8 Trench Width 36" Max Trench Bottom Depth 36" Gravel Depth N/A

New System Repair System Type: I II III IV V VI
System Description ~~Conv~~ Gravity 25% Red.
Repair System Description
Maintenance Agreement Required Yes ~~No~~
Slab ~~Crawl Space~~ Basement w/plumbing Basement w/o plumbing


~~House/Mod~~ Home No Bedrooms 3
Mobile Home No Bathrooms 2
Business No Employees
Other

Water Supply: ☐ Individual ~~Public~~ ☐ Community

Comments/Conditions:

Comments/Conditions

INITIAL SITE SKETCH 150'

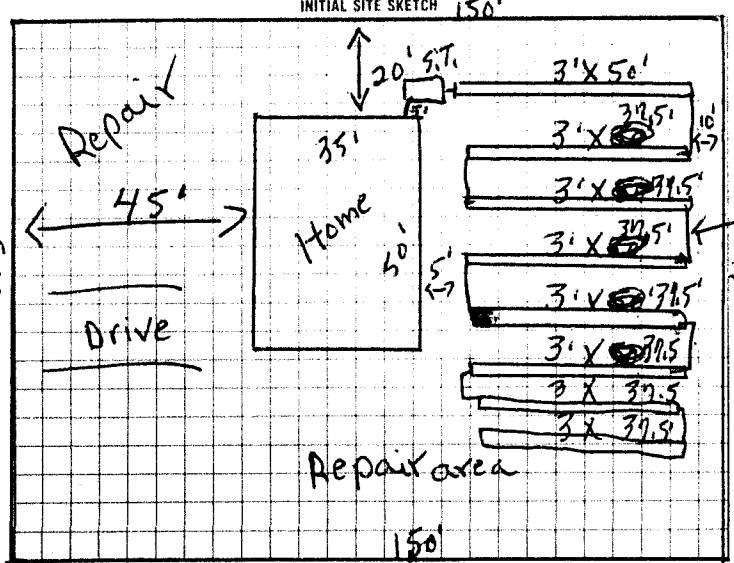

AS BUILT SKETCH

Same as initial Sketch Except 8 Lines used instead of 6

I understand that this permit can be suspended or revoked if any false information is supplied toward securing the permit/any unauthorized changes are made to the site/any unauthorized changes are made in the installation of the system. Improvement Permit with plat valid without expiration. Improvement Permit with site plan valid for sixty months. Authorization to Construct is valid for a period equal to that of Improvement Permit – not to exceed sixty months.

Signed: [signature] date 10-27-98 Installed by: Rowan S.T. Co.

Improvement Permit by: E.C. Moore date 10-17-98 Operation Permit by: E.C. Moore date 2-09-00

Authorization to Construct by: E.C. Moore date 10-17-98 Existing System Inspection by: date

HEALTH DEPT. COPY. WHITE INSPECTION COPY (FINAL) GREEN OWNER COPY (FINAL) YELLOW INSPECTION COPY (INITIAL) PINK OWNER COPY (INITIAL) GOLD