1:36

IREDELL COUNTY HEALTH DEPARTMENT - *ENVIRONMENTAL HEALTH* ☒ STATESVILLE OFFICE 704-878-5305 ☐ MOORESVILLE OFFICE 704-664-5281

IMPROVEMENT PERMIT / AUTHORIZATION TO CONSTRUCT / OPERATION PERMIT / EXISTING SYSTEM INSPECTION

PERMIT # Repair PIN # 4730-57-6600 DATE 7-9-12

OWNER James L. Talbert APPLICANT: PHONE: Home/Cell # 704 230 9821 Business # 704-528-0780

SITE ADDRESS 147 State Park Rd OWNER / APPLICANT ADDRESS 147 State Park Rd.

SITE DIRECTIONS 21S (R) Perth (R) State Park, site on (L) at corner of Pinecroft & State Park

SUBDIVISION Pinecroft BLOCK / SECTION NA LOT # 10 LOT AREA .459 Ac. DESIGN FLOW 360 L.T.A.R. .25

Septic Tank ex. Gallons: STB ex. Date ex.
Pump Tank — Gallons: P T — Date —
Pump Make — Model — Serial # —
No. Nitrification Fields: 1 No. Lines 1 Linear Feet 130'
Trench Width 36" Max. Trench Bottom Depth 36" Gravel Depth n/a

☐ New System ☒ Repair ☐ Expansion System Type I II (III) IV V VI
System Description: conventional gravity
Repair System Description: 25% Reduction gravity
Maintenance Agreement Required ☐ YES ☒ NO
☒ GRAVITY ☐ PRESSURE


☒ Residence No. Bedrooms 3
☐ Business No. Persons —
☐ Other No. Employees —
☐ Slab ☒ Crawl Space
☐ Basement w/plumbing ☐ Basement w/o plumbing

Water Supply: ☒ Private ☐ Public ☐ Community


Comments / Conditions: Add 130' of 25% Reduction System

STATE PARK RD.

INITIAL SITE SKETCH

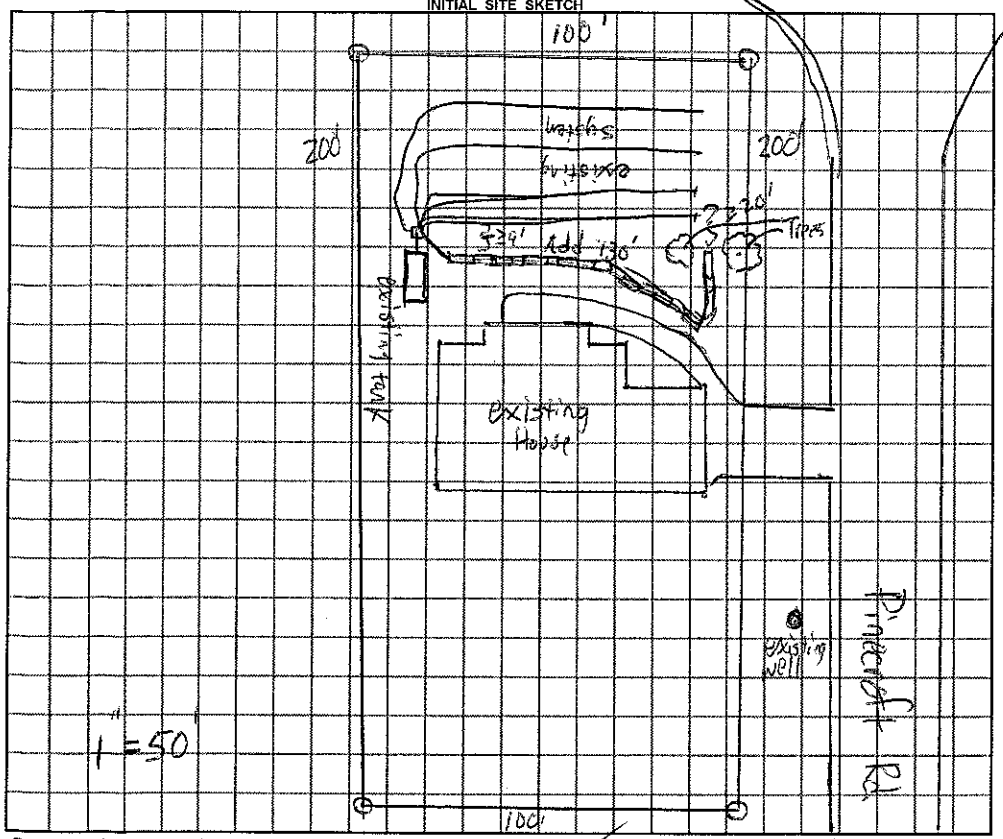

AS BUILT SKETCH

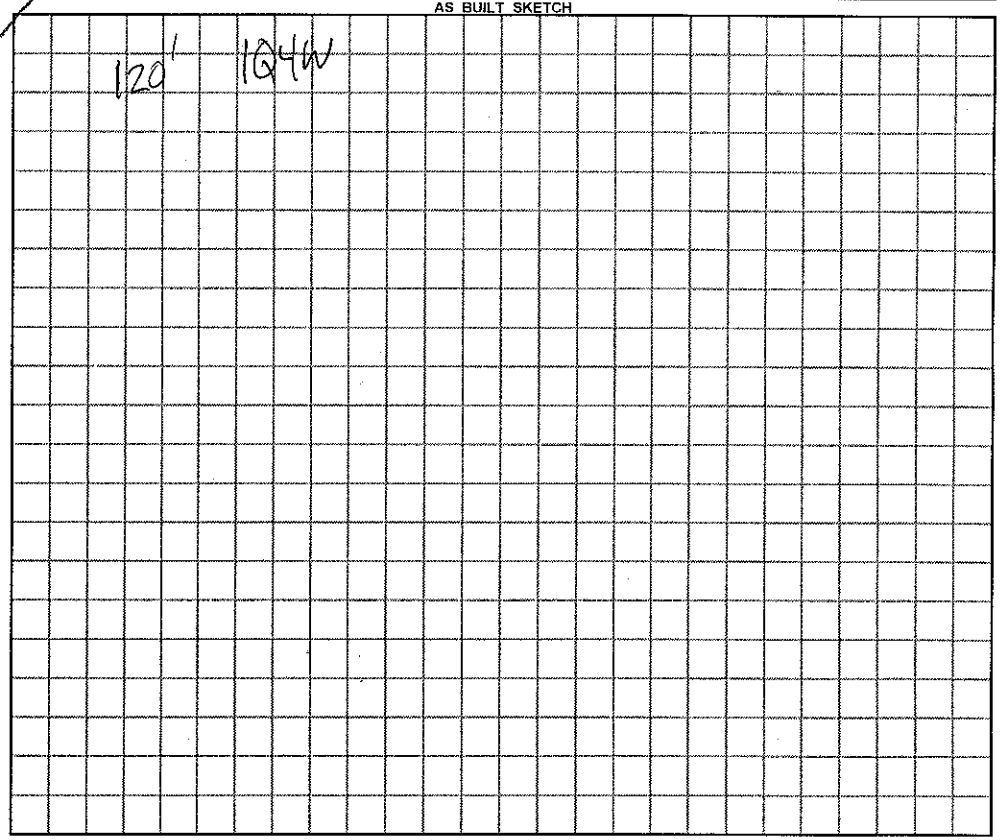

Permit can be suspended or revoked if any false information is supplied toward securing the permit / any unauthorized changes are made to the site / any unauthorized changes are made in the installation of the system.

☐ ***IMPROVEMENT PERMIT*** with plat valid without expiration. ☒ ***IMPROVEMENT PERMIT*** with ~~plat valid without expiration.~~ site plan valid 60 mo. ☒ ***AUTHORIZATION TO CONSTRUCT*** valid for period equal to IMPROVEMENT PERMIT--not to exceed 60 mo.

Owner / Applicant Signature: Date 7-25-12 Installed by: Piedmont Septic Tank

IMPROVEMENT PERMIT by: REHS Date 7-9-12 OPERATION PERMIT by: REHS Date 8-16-12

AUTHORIZATION TO CONSTRUCT by: REHS Date 7-9-12 Existing System Inspected by: REHS Date

YOU SHOULD CONTACT A LOCATOR SERVICE PRIOR TO ANY EXCAVATION

White Copy – Environmental Health YELLOW COPY (Final) Owner / Applicant PINK COPY (Initial) Owner / Applicant