87649

IREDELL COUNTY HEALTH DEPARTMENT

STATESVILLE 704-878-5305 MOORESVILLE 704-664-5281

IMPROVEMENT PERMIT / AUTHORIZATION TO CONSTRUCT / OPERATION PERMIT / EXISTING SYSTEM INSPECTION

PERMIT# 14-2-699 TROUTMAN PIN# 4730 48 6413 DATE 9/1/99

OWNER OR CONTRACTOR ~~SPEAR CONSTRUCTION~~ C&S ASSOCIATES PHONE: Business 361-7518 Home

ADDRESS 607 ANDERSON AVE SALISBURY NC 28147

LOCATION PERTH RD - S - TR MEADOW GLEN DRIVE - TL PARKVISTA - FIRST ON RT

SUBDIVISION MEADOW GLEN BLOCK / SECTION 1 LOT 52 LOT AREA SITE CLASS PS DESIGN FLOW 360 L.T.A.R. .3

Septic Tank: 1000 Gallons; STB ~~[illegible]~~ Date 8/16/00
Pump Tank: Gallons; PT Date
Pump Make: Model Serial No.
Nitrification Field: No Fields 1 Square Feet 900 Linear Feet 300
No Lines 5@60 Trench Width 36" Max Trench Bottom Depth 36" Gravel Depth N/A

☑ New System ☐ Repair System Type: I, II, (III), IV, V, VI
System Description: GRAVITY 25% REDUCTION
Repair System Description: ~~[illegible]~~ LPP PANEL
Maintenance Agreement Required: ☐ Yes ☑ No


☑ House/Mod. Home No. Bedrooms 3
☐ Mobile Home No. Bathrooms 2
☐ Business No. Employees
☐ Other
☐ Slab ☑ Crawl Space ☐ Basement w/plumbing ☐ Basement wo/plumbing

Water Supply: ☐ Individual ☑ Public ☐ Community

Comments/Conditions:

Comments/Conditions Polylok filter - Infiltrators installed

INITIAL SITE SKETCH

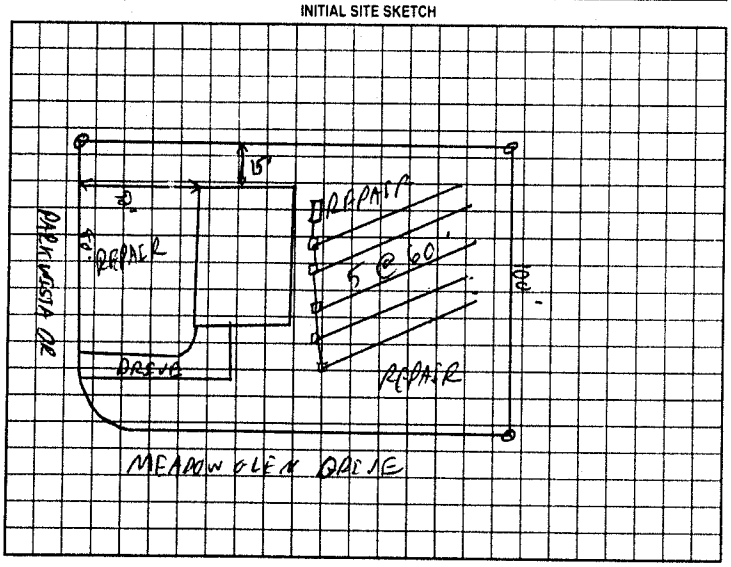

AS BUILT SKETCH

Permit can be suspended or revoked if any false information is supplied toward securing the permit/any unauthorized changes are made to the site/any unauthorized changes are made in the installation of the system. Improvement Permit with plat valid without expiration. Improvement Permit with site plan valid for sixty months. Authorization to Construct is valid for a period equal to that of Improvement Permit – not to exceed sixty months.

Signed: [signature] date 11-8-99

Improvement Permit by: [signature] RS date 9/1/99

Authorization to Construct by: [signature] RS date 9/1/99

Installed by: Wayne Clontz

Operation Permit by: [signature] RSI date 10/31/00

Existing System Inspection by: date

HEALTH DEPT COPY: WHITE OWNER COPY (FINAL) YELLOW OWNER COPY (INITIAL) PINK