137380

IREDELL COUNTY HEALTH DEPARTMENT

STATESVILLE 704-878-5305 MOORESVILLE 704-664-5281

IMPROVEMENT PERMIT / AUTHORIZATION TO CONSTRUCT / OPERATION PERMIT / EXISTING SYSTEM INSPECTION

PERMIT# ~~03-P-05-06~~ PIN# 4730-58-0886 DATE 7-14-06

OWNER OR APPLICANT Cecil Stroney LLC PHONE: Business 704-528-1919 Home 704-663-1518

ADDRESS 199 WADDELL RD MOORESVILLE, NC 28117

LOCATION 215 @ FORK @ State Park @ MEADOW GLEN @ VALLEY GLEN @ Scotch Irish 1st LOT ON LEFT

SUBDIVISION MEADOW GLEN BLOCK / SECTION IV LOT 139 LOT AREA .5715 AC SITE CLASS. PS DESIGN FLOW 360 L.T.A.R. .3

Septic Tank: 1000 Gallons; STB 1012 Date 12-6-06
Pump Tank: _____ Gallons; PT _____ Date _____
Pump Make: _____ Model _____ Serial No. _____
Nitrification Field: No Fields 1 Square Feet EB=1700 Linear Feet 200'
No Lines 5x40' Trench Width 24" Max Trench Bottom Depth 36"

☒ New System ☐ Repair ☐ Expansion System Type: I II III IV V VI
System Description: 6 Bdrm 50%
Repair System Description: LP 50% / FRONT DOOR BEHIND HOUSE
Maintenance Agreement Required: ☐ Yes ☒ No


☒ House/Mod. Home ☐ Mobile Home ☐ Business ☐ Other
No. Bedrooms 3 No. Persons 6 No. Employees _____

Water Supply: ☐ Individual ☒ Public ☐ Community

Gravel Depth 24" ☒ Gravity ☐ Pressure ☐ Slab ☒ Crawl Space ☐ Basement w/plumbing ☐ Basement wo/plumbing

Comments/Conditions: ① Keep House Out of Ground & ADD FILL to Keep FALL TO Septic TANK ② INSTALL LINES ON CONTOURS ③ MAINTAIN SETBACKS ④ USE EFFLUENT SPLITTER (such as Zoeller In Flow Splitter) to achieve equal distribution. TURF TITE Filter & DRAINS INSTALLED DURING WET SOIL CONDITIONS OVER 2 WEEK PERIOD

INITIAL SITE SKETCH 1"=40'

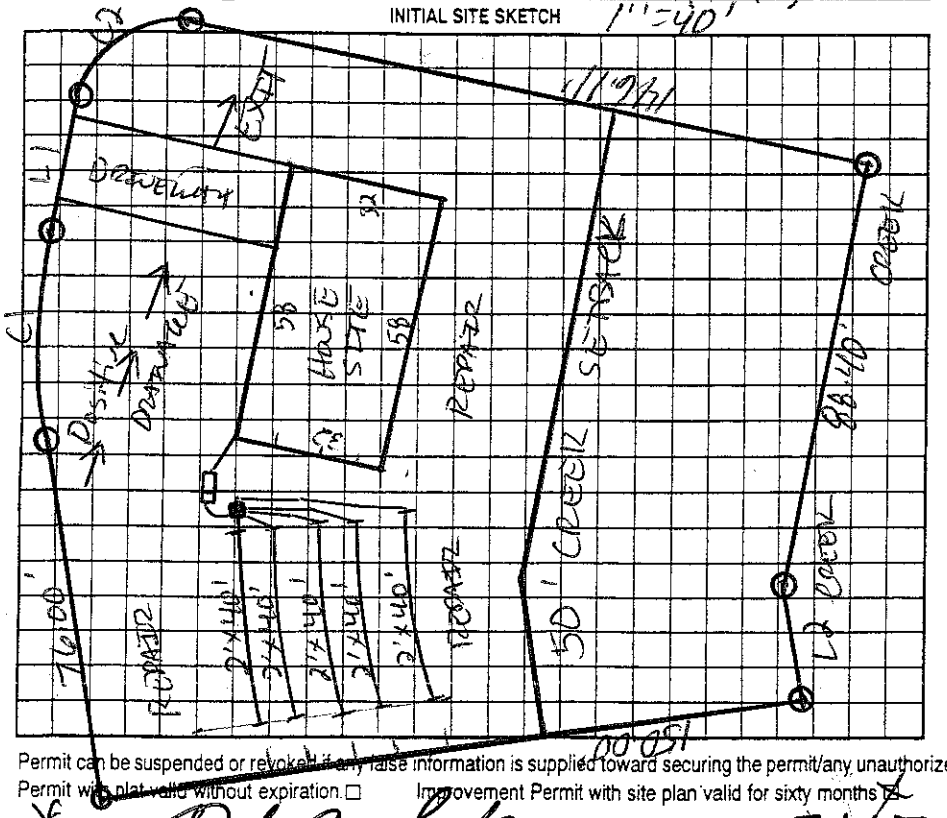

AS BUILT SKETCH

Permit can be suspended or revoked if any false information is supplied toward securing the permit/any unauthorized changes are made to the site/any unauthorized changes are made in the installation of the system. Improvement Permit with plat valid without expiration. ☐ Improvement Permit with site plan valid for sixty months ☒ Authorization to Construct is valid for a period equal to that of Improvement Permit – not to exceed sixty months.

Signed: [signature] date 7/7

Improvement Permit by: [signature] date 7-17-06

Authorization to Construct by: [signature] date 7/21/06

Installed by: ROBBIE BROWN

Operation Permit by: [signature] date 11-17-06

Existing System Inspection by: _____ date _____

HEALTH DEPT. COPY: WHITE OWNER COPY (FINAL): YELLOW OWNER COPY (INITIAL): PINK