IREDELL COUNTY HEALTH DEPARTMENT

STATESVILLE 704-878-5305 MOORESVILLE 704-664-5281

IMPROVEMENT PERMIT / AUTHORIZATION TO CONSTRUCT / OPERATION PERMIT / EXISTING SYSTEM INSPECTION

PERMIT# 25-2-699 83165 PIN# 4730-48-6413 DATE July 28, '99

OWNER OR CONTRACTOR Green Construction // C&S Assoc. PHONE: Business (704) 361-7578 / 336-495-4111 Home

ADDRESS 607 Anderson Ave Salisbury // 904 Glen St. Thomasville 27360

LOCATION Tyotown Path Rd. South TR State Park Rd. TR Meadow Glen Drive TL Meadow Glen Circle on Right

SUBDIVISION Meadow Glen BLOCK / SECTION LOT 38 LOT AREA .3748 Ac SITE CLASS PS DESIGN FLOW 360 gpd L.T.A.R .25-.3

Septic Tank: 1000 Gallons: STB 823 Date 8 26 99
Pump Tank: Gallons: PT Date
Pump Make: Model Serial No.
Nitrification Field: No Fields 1 Square Feet 1080 Linear Feet 360
No Lines 4@90' Trench Width 36" Max Trench Bottom Depth ~24"

☑ New System ☐ Repair System Type: I II III IV V VI
System Description: GRAVITY INNOVATIVE-25% Red
Repair System Description GRAVITY pumped INNOVATIVE PANEL Black
Maintenance Agreement Required: ☐ Yes ☑ No
Gravel Depth N/A

☑ House/Mod. Home No. Bedrooms 3
☐ Mobile Home No. Bathrooms 2
☐ Business No. Employees
☐ Other

☑ Slab ☐ Crawl Space ☐ Basement w/plumbing ☐ Basement wo/plumbing


Water Supply: ☐ Individual ☑ Public ☐ Community

Comments/Conditions: * ONE inspection port per Lateral


Comments/Conditions

1"=50'

INITIAL SITE SKETCH

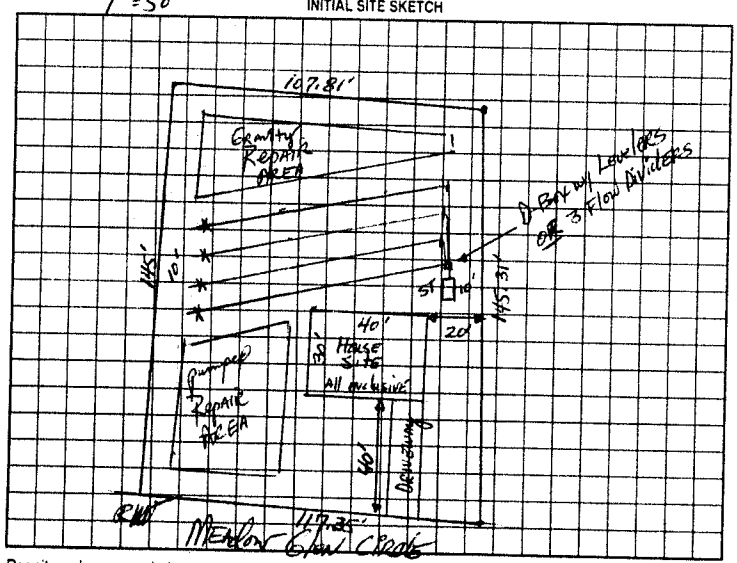

AS BUILT SKETCH

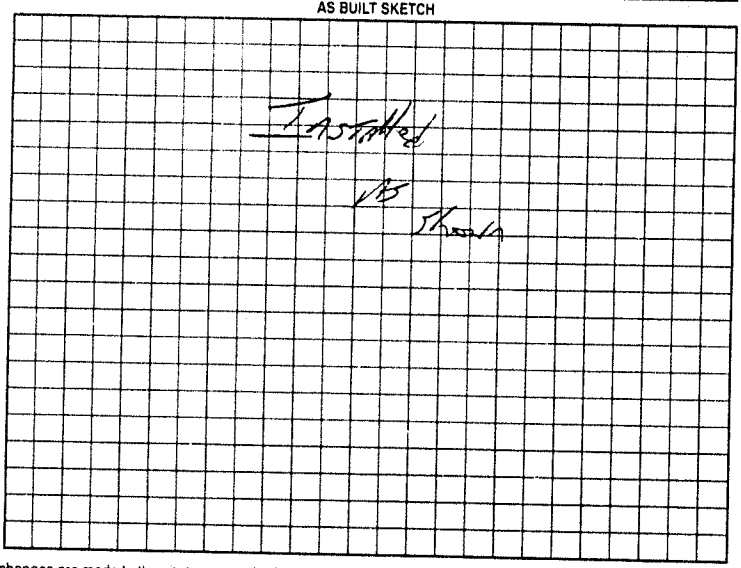

Permit can be suspended or revoked if any false information is supplied toward securing the permit/any unauthorized changes are made to the site/any unauthorized changes are made in the installation of the system. Improvement Permit with plat valid without expiration. Improvement Permit with site plan valid for sixty months. Authorization to Construct is valid for a period equal to that of Improvement Permit – not to exceed sixty months.

Signed:

Improvement Permit by: date 7-28-99

Authorization to Construct by: date 7-28-99

Installed by: Rogers Septic

Operation Permit by: date Oct 6 99

Existing System Inspection by: date

HEALTH DEPT COPY WHITE OWNER COPY (FINAL) YELLOW OWNER COPY (INITIAL) PINK