IREDELL COUNTY HEALTH DEPARTMENT

STATESVILLE 704-878-5305 MOORESVILLE 704-664-5281

IMPROVEMENT PERMIT / AUTHORIZATION TO CONSTRUCT / OPERATION PERMIT / EXISTING SYSTEM INSPECTION

PERMIT# 97-I-699 PIN# 4730-48-6413

OWNER OR CONTRACTOR Spear Construction // C&S Assoc. PHONE: Business 361-7518 // (Cell) 475-4111 Home DATE July 29, '99

ADDRESS 607 Anderson Ave, Salisbury 28144 // 904 Salem St, Thomasville 27360

LOCATION Ingram, Perth Rd South TR State Park Rd. TR Meadowlark DRIVE on left - corner lot after/ Whitney Lane

SUBDIVISION Meadow Glen BLOCK / SECTION LOT 40 LOT AREA .3761 Ac SITE CLASS PS DESIGN FLOW 360 gpd L.T.A.R. .3

Septic Tank: 1000 Gallons; STB 1007 Date 5 19 00

Pump Tank: 1000 Gallons; PT 274 Date

Pump Make: Zoeller Model A137-C Serial No. 3N137 0002

Nitrification Field: No Fields 1 Square Feet 900+ Linear Feet 300+

No Lines 4@75'+ Trench Width 36" Max Trench Bottom Depth N24" Gravel Depth NA

☑ New System ☐ Repair System Type: I, II, (III), IV, V, VI

System Description: PM-INNOVATIVE-HDS 2012 HORIZONTAL

Repair System Description: LP PANEL Block

Maintenance Agreement Required: ☐ Yes ☑ No initially

☑ House/Mod. Home No. Bedrooms 3

☐ Mobile Home No. Bathrooms 2

☐ Business No. Employees

☐ Other


☑ Slab ☐ Crawl Space ☐ Basement w/plumbing ☐ Basement wo/plumbing

Water Supply: ☐ Individual ☑ Public ☐ Community


Comments/Conditions:

Comments/Conditions BACK FLOW VALVE USE
48 inFILTER
7-21 Pump PRESSURESET Alarm Checked-ok TRATOR Chamber Used

INITIAL SITE SKETCH 1" = 50'

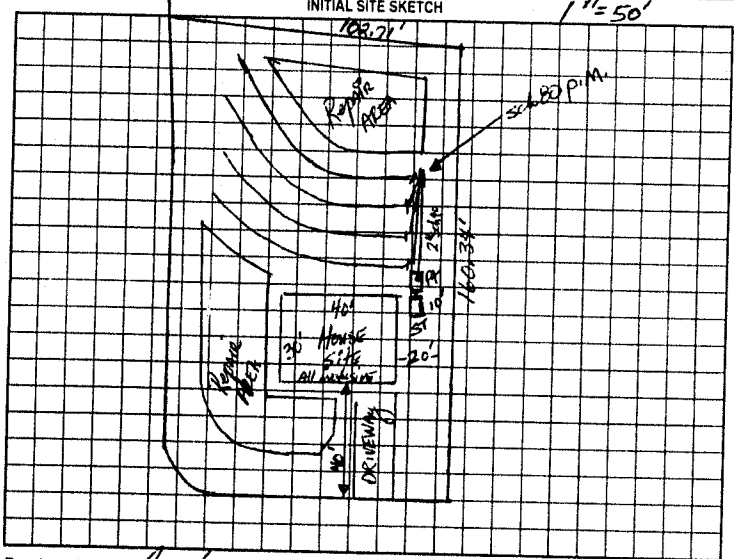

AS BUILT SKETCH

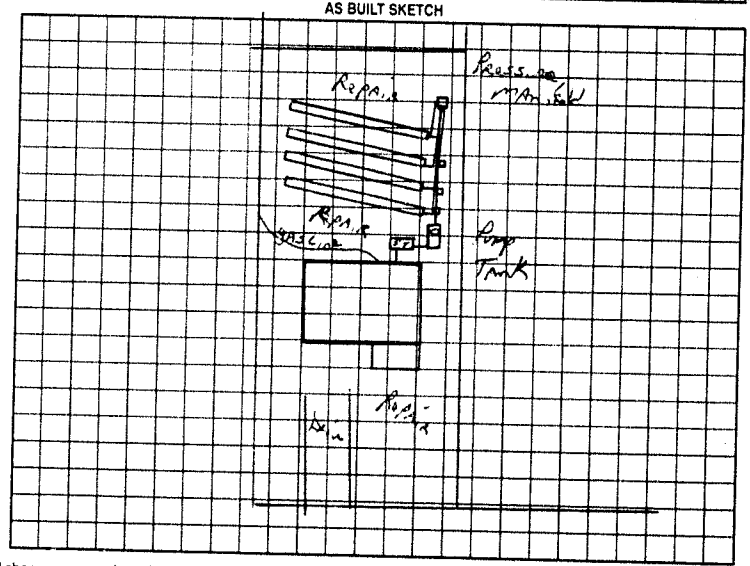

Permit can be suspended or revoked if any false information is supplied toward securing the permit/any unauthorized changes are made to the site/any unauthorized changes are made in the installation of the system. Improvement Permit with plat valid without expiration. Improvement Permit with site plan valid for sixty months. Authorization to Construct is valid for a period equal to that of Improvement Permit - not to exceed sixty months.

Signed: _____ date 8-2-99

Improvement Permit by: _____ date 7-29-99

Authorization to Construct by: _____ date 7-29-99

Installed by: Wayne County

Operation Permit by: _____ date July 21 2000

Existing System Inspection by: _____ date _____

HEALTH DEPT COPY: WHITE OWNER COPY (FINAL) YELLOW OWNER COPY (INITIAL) PINK