IREDELL COUNTY HEALTH DEPARTMENT

THIS PERMIT VOIDS PREVIOUS ISSUED 10-30-01

STATESVILLE 704-878-5305 MOORESVILLE 704-664-5281

IMPROVEMENT PERMIT / AUTHORIZATION TO CONSTRUCT / OPERATION PERMIT / EXISTING SYSTEM INSPECTION

PERMIT# TRAUGHMAN PIN# 4730 58 1782 DATE 8-5-02

OWNER OR CONTRACTOR PATRICK BURKE PHONE: Business 704-361-0047 Home

ADDRESS C/O 4447 LAKE DR., SHERRILLS FORD, NC 28673

LOCATION STATE PARK ROAD, TR MEADOW GLEN DR, TR NEXT STREET, TR SCOTCH-IRISH LANE, 1ST ON RIGHT

SUBDIVISION MEADOW GLEN BLOCK / SECTION IV LOT 138 LOT AREA 0.386 ACRE SITE CLASS. PS DESIGN FLOW 360 L.T.A.R. 0.30 GPD/FT²

Septic Tank: 1000 Gallons; STB 794 Date 06/01/02

Pump Tank: ____ Gallons; PT ____ Date ____

Pump Make: ____ Model ____ Serial No. ____

Nitrification Field: No Fields 1 Square Feet EQ @ 1200 Linear Feet 200

No Lines FOUR Trench Width 24" Max Trench Bottom Depth 36" ~~Gravel~~ Depth SAND 6"

☑ New System ☐ Repair System Type: I, II, (III), IV, V, VI

System Description: 50% REDUCTION, GRAVITY

Repair System Description: 50% REDUCTION LAND - PRESSURE

Maintenance Agreement Required: ☐ Yes ☑ No

☑ House/Mod. Home No. Bedrooms 3

☐ Mobile Home No. Bathrooms 2

☐ Business No. Employees ____

☐ Other ____

☑ Slab ☐ Crawl Space ☐ Basement w/plumbing ☐ Basement wo/plumbing


Water Supply: ☐ Individual ☑ Public ☐ Community

Comments:/Conditions: INSTALL 50% REDUCTION SYSTEM USING 44 PRPS PANELS IN FOUR EQUAL LENGTH LINES


Comments:/Conditions: - SEPTIC TANK INSTALLED USING ZEBEL FILTER.

SCALE: 1"=30'

INITIAL SITE SKETCH

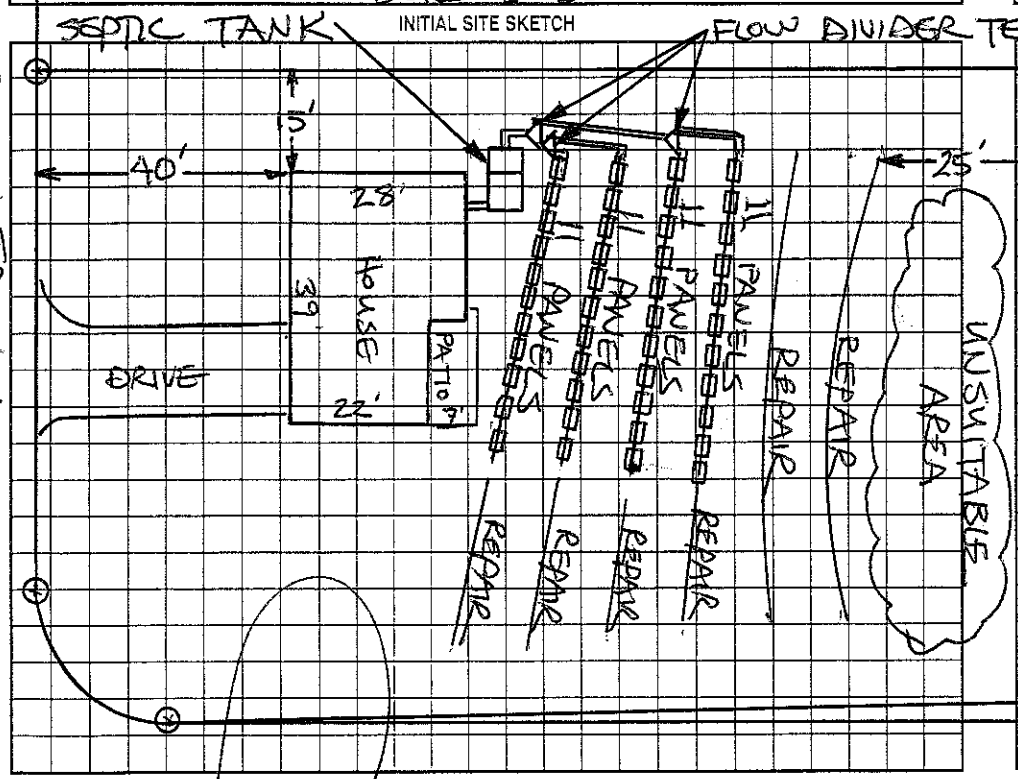

AS BUILT SKETCH

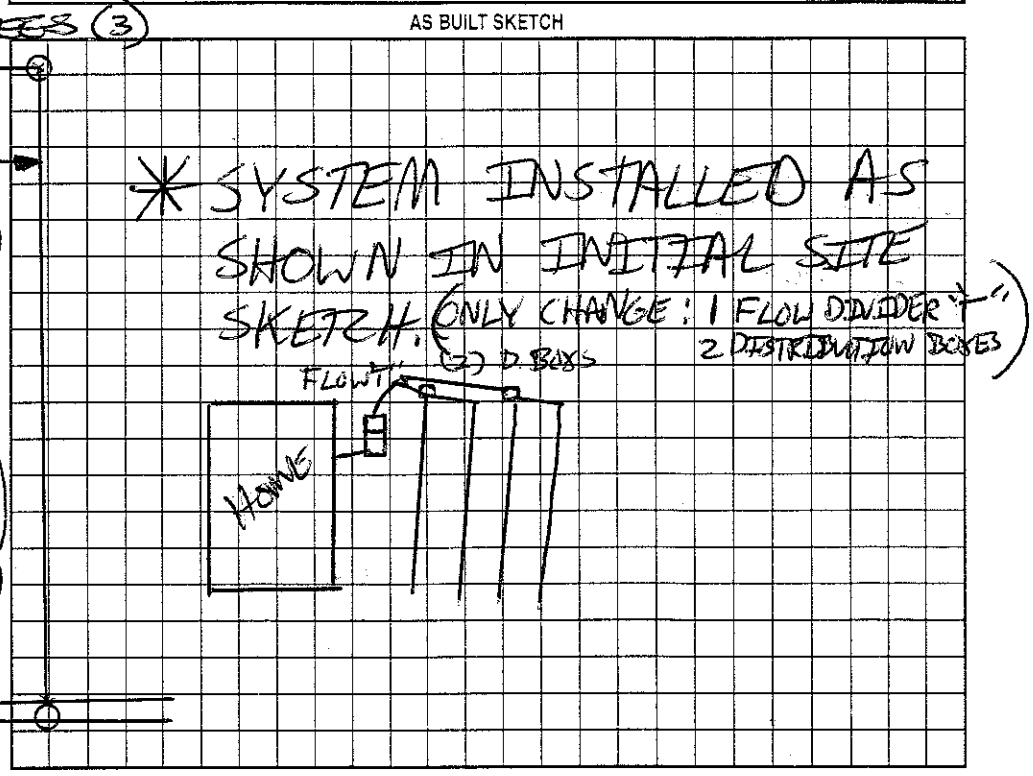

Permit can be suspended or revoked if any false information is supplied toward securing the permit/any unauthorized changes are made to the site/any unauthorized changes are made in the installation of the system. Improvement Permit with plat valid without expiration. Improvement Permit with site plan valid for sixty months. Authorization to Construct is valid for a period equal to that of Improvement Permit – not to exceed sixty months.

Signed: ____ date 8/5/02 Installed by: RICHARD ABERNATHY

Improvement Permit by: STEVE HEDRICK date 8-5-02 Operation Permit by: ____ date 01/16/03

Authorization to Construct by: STEVE HEDRICK date 8-5-02 Existing System Inspection by: ____ date ____

HEALTH DEPT. COPY: WHITE OWNER COPY (FINAL): YELLOW OWNER COPY (INITIAL): PINK