IREDELL COUNTY HEALTH DEPARTMENT

STATESVILLE 704-878-5305 MOORESVILLE 704-664-5281

IMPROVEMENT PERMIT / AUTHORIZATION TO CONSTRUCT / OPERATION PERMIT / EXISTING SYSTEM INSPECTION

71x40 315.00 tq.ft

PERMIT# 11-p-02-04 | 12397 PIN# ~~4730488453~~ 4730-58-2644 DATE June 14, 04

OWNER OR CONTRACTOR Cecil-Stamey LLC PHONE: Business _____ Home _____

ADDRESS 125 East Plaza Dr. | 108 Westfield office Cir, Mooresville N.C. 28115

LOCATION State Park Rd. TR into Meadow Glen TR 1st Street TR Scotch Irish Ln. 2nd Lot on Right

SUBDIVISION Meadow Glen BLOCK / SECTION 4 LOT 137 LOT AREA .367 ac SITE CLASS PS DESIGN FLOW 360 gpd L.T.A.R. .25-.3 Frontyard

Septic Tank: 1000 Gallons; STB BDS Date 10-18-04

Pump Tank: 1000 Gallons; PT 350 Date 10-11-04

Pump Make: Zoeller Model N-137 Serial No. _____

Nitrification Field: No Fields 1 Square Feet 440 Linear Feet 220

No Lines 3 @ 73'± Trench Width 24" min 8'oc Max Trench Bottom Depth 36" Gravel Depth NA

☑ New System ☐ Repair System Type: I, II, III, (IV) V, VI

System Description: LPPPBPS

Repair System Description: LPPPBPS

Maintenance Agreement Required: ☑ Yes ☐ No

☐ House/Mod. Home No. Bedrooms 3

☐ Mobile Home No. Bathrooms 2±

☐ Business No. Employees ____

☐ Other _____


☐ Slab ☐ Crawl Space ☐ Basement w/plumbing ☑ Basement wo/plumbing

Water Supply: ☐ Individual ☑ Public ☐ Community


Comments:/Conditions: IN LINE filter required in pump tank.

Comments:/Conditions: APPROVED HOUSE PLAN (EN) 6-7-04 LL
POLYLOK FILTER & MARKER
NEEDS ELECTRICAL & CONTRACT
V'D ELECTRICAL & CONTACT ON 2-7-05

INITIAL SITE SKETCH 1"=50'

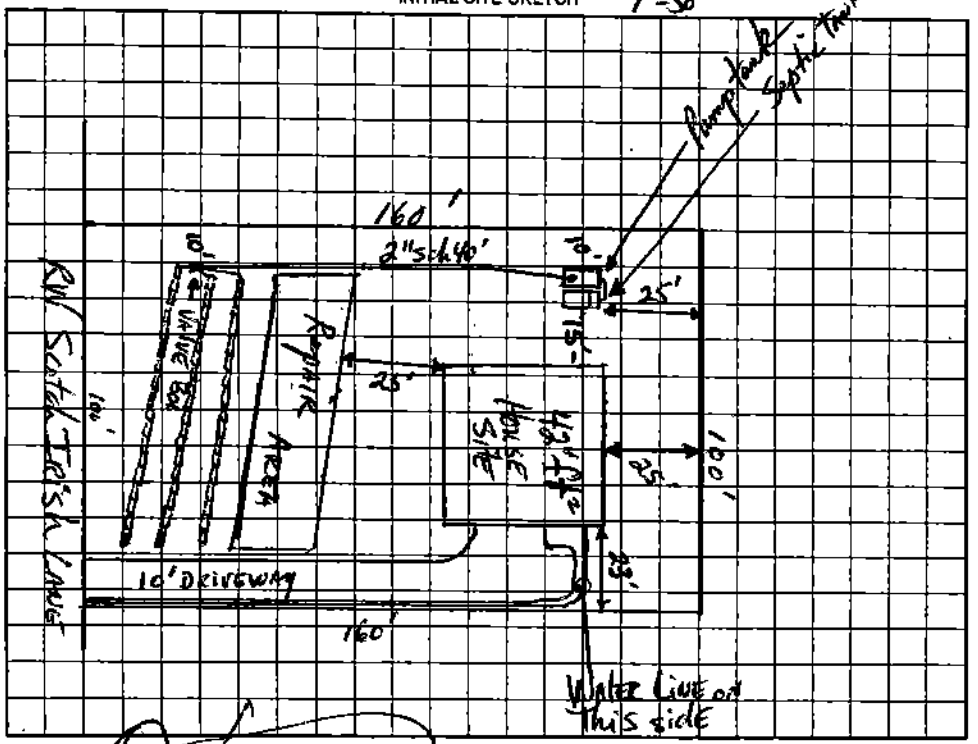

AS BUILT SKETCH EVERYTHING OK

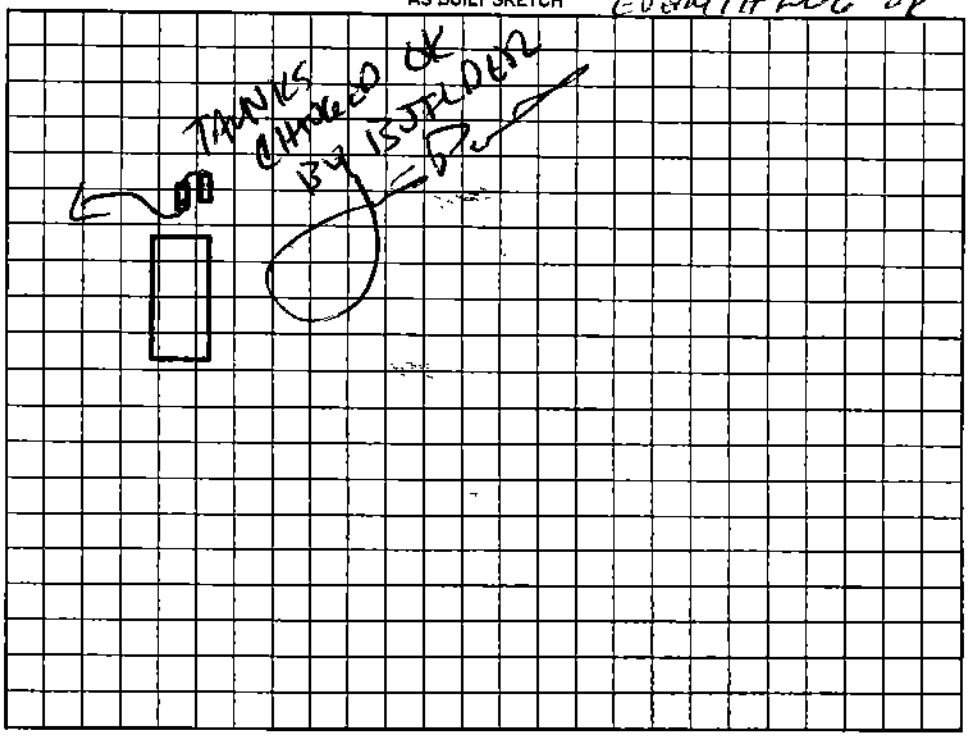

Permit can be suspended or revoked if any false information is supplied toward securing the permit/any unauthorized changes are made to the site/any unauthorized changes are made in the installation of the system. Improvement Permit with plat valid without expiration. Improvement Permit with site plan valid for sixty months. Authorization to Construct is valid for a period equal to that of Improvement Permit – not to exceed sixty months.

Signed: _____ date 6-7-04 Installed by: ROWAN SEPTIC

Improvement Permit by: _____ date 6-14-04 Operation Permit by: _____ date 2-7-05

Authorization to Construct by: _____ date 6-7-04 Existing System Inspection by: _____ date _____

HEALTH DEPT. COPY: WHITE OWNER COPY (FINAL): YELLOW OWNER COPY (INITIAL): PINK